

LEGEND

- END STRUCTURE
- LIP-IN-LINE GULLY PIT
- FIELD INLET
- MAINTENANCE HOLE
- DRAINAGE PIPE
- SEDIMENT FOREBAY
- STREET SIGN
- BARRIER KERB AND CHANNEL - B1
- BARRIER KERB - B6
- BARRIER KERB - B2
- MOUNTABLE KERB AND CHANNEL - M1
- MOUNTABLE KERB - M5
- SEMI-MOUNTABLE KERB - SM3
- INVERT CHANNEL - INV600
- RETAINING WALL
- BARRIER FENCE / BOLLARD RUN

ENGINEERS CERTIFICATION

I, Daniel Gibson, hereby certify that:

1. The information contained in this drawing / document is in compliance with approved drawings and design.
2. This represents an accurate record of as-constructed works.
3. I accept responsibility for the information contained in this drawing / document. In accepting this responsibility we have relied upon information provided by others.

CERTIFICATION FOR HARMONY RELEASE 23

RPEQ Signature: *[Signature]* RPEQ No. 23875 Date 28/03/23

For and on behalf of CALIBRE CONSULTING (QLD) PTY LTD.

I, Jarrod Hill being a Cadastral Surveyor and duly authorised representative of RPS AAP Consulting Pty Ltd.


hereby --

- certify the information contained in this drawing is an accurate "as-constructed" representation of the works.
- accept responsibility for the location of the "as-constructed" information contained in this drawing.
- acknowledge the "as-constructed" information contained in the drawing may be relied on by Council and others.

Certification for Stages HARMONY RELEASE 23 by *[Signature]* on 28/03/23
(stage no) (signature) (date)

for RPS AAP Consulting Pty Ltd.

SUGAR MILL ROAD
SURFACE: 50mm AC
BASE: 175mm GR21
SUB BASE: 175mm GR23
LOWER SUB BASE: 275mm GR25
SUBGRADE REPLACEMENT: 250mm GR25
SUBGRADE CBR: 1.5

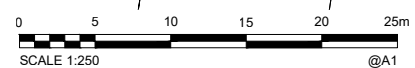

AS CONSTRUCTED

A1							
INDEX	DATE	AS-CONSTRUCTED DETAILS	REVISIONS	DRAWN	CHECKED	PASSED	
0	24/03/2023			LG	BS		

DRAWN	LG	24/03/2023
CHECKED	BS	24/03/2023
PASSED		
INITIALS	DATE	

Calibre Professional Services Pty Ltd
 Level 4, Unit 401, 8 Market Lane,
 Maroochydore, QLD 4658
 Telephone 07 5314 2520
 Facsimile 07 5314 2522
 © calibregroup.com

Sunshine Coast
 COUNCIL

SUNSHINE COAST COUNCIL

 ROADS AND DRAINAGE
 HARMONY - RELEASE 23
 COUNCIL REFERENCE: OPW21/045.01

SCALE	1:250
SHEET 1	OF 6 SHEETS
DRAWING NO.	

ENGINEERS CERTIFICATION

1. Daniel Gibson hereby certify that:
 2. The information contained in this drawing / document is in compliance with approved drawings and design.
 3. This represents an accurate record of as-constructed works.
 I accept responsibility for the information contained in this drawing / document. In accepting this responsibility we have relied upon information provided by others.

CERTIFICATION FOR HARMONY RELEASE 23

RPEQ Signature *[Signature]* RPEQ No. 23875 Date 28/03/23
 For and on behalf of CALIBRE CONSULTING (QLD) PTY LTD.

I Jarrod Hill being a Cadastral Surveyor and duly authorised representative of RPS AAP Consulting Pty Ltd.
 hereby:-
 • certify the information contained in this drawing is an accurate "as-constructed" representation of the works.
 • accept responsibility for the location of the "as-constructed" information contained in this drawing.
 • acknowledge the "as-constructed" information contained in the drawing may be relied on by Council and others.

Certification for Stages HARMONY RELEASE 23 by *[Signature]* on 28/03/23
 (stage no.) (signature) (date)
 for RPS AAP Consulting Pty Ltd.



- LEGEND**
- END STRUCTURE
 - LIP-IN-LINE GULLY PIT
 - FIELD INLET
 - MAINTENANCE HOLE
 - DRAINAGE PIPE
 - SEDIMENT FOREBAY
 - STREET SIGN
 - BARRIER KERB AND CHANNEL - B1
 - BARRIER KERB - B6
 - BARRIER KERB - B2
 - MOUNTABLE KERB AND CHANNEL - M1
 - MOUNTABLE KERB - M5
 - SEMI-MOUNTABLE KERB - SM3
 - INVERT CHANNEL - INV600
 - RETAINING WALL
 - BARRIER FENCE / BOLLARD RUN

0 5 10 15 20 25m
 SCALE 1:250 @A1

AS CONSTRUCTED

A1	0	24/03/2023	AS-CONSTRUCTED DETAILS	LG	BS		
	INDEX	DATE	REVISIONS	DRAWN	CHECKED	PASSED	

DRAWN	LG	24/03/2023
CHECKED	BS	24/03/2023
PASSED		
INITIALS	DATE	



SUNSHINE COAST COUNCIL

ROADS AND DRAINAGE
 HARMONY - RELEASE 23
 COUNCIL REFERENCE: OPW21/0455.01

SCALE	1:250
SHEET 2	OF 6 SHEETS
DRAWING NO.	

ENGINEERS CERTIFICATION

1. Daniel Gibson hereby certify that:
 2. The information contained in this drawing / document is in compliance with approved drawings and design.
 3. This represents an accurate record of as-constructed works.
 I accept responsibility for the information contained in this drawing / document. In accepting this responsibility we have relied upon information provided by others.


CERTIFICATION FOR HARMONY RELEASE 23

RPEQ Signature *[Signature]* RPEQ No. 23875 Date 28/03/23
 For and on behalf of CALIBRE CONSULTING (QLD) PTY LTD.

I Jarrod Hill being a Cadastral Surveyor and duly authorised representative of RPS AAP Consulting Pty Ltd.

hereby:-
 • certify the information contained in this drawing is an accurate "as-constructed" representation of the works.
 • accept responsibility for the location of the "as-constructed" information contained in this drawing.
 • acknowledge the "as-constructed" information contained in the drawing may be relied on by Council and others.

Certification for Stages HARMONY RELEASE 23 by *[Signature]* on 28/03/23
 (stage no.) (signature) (date)
 for RPS AAP Consulting Pty Ltd.

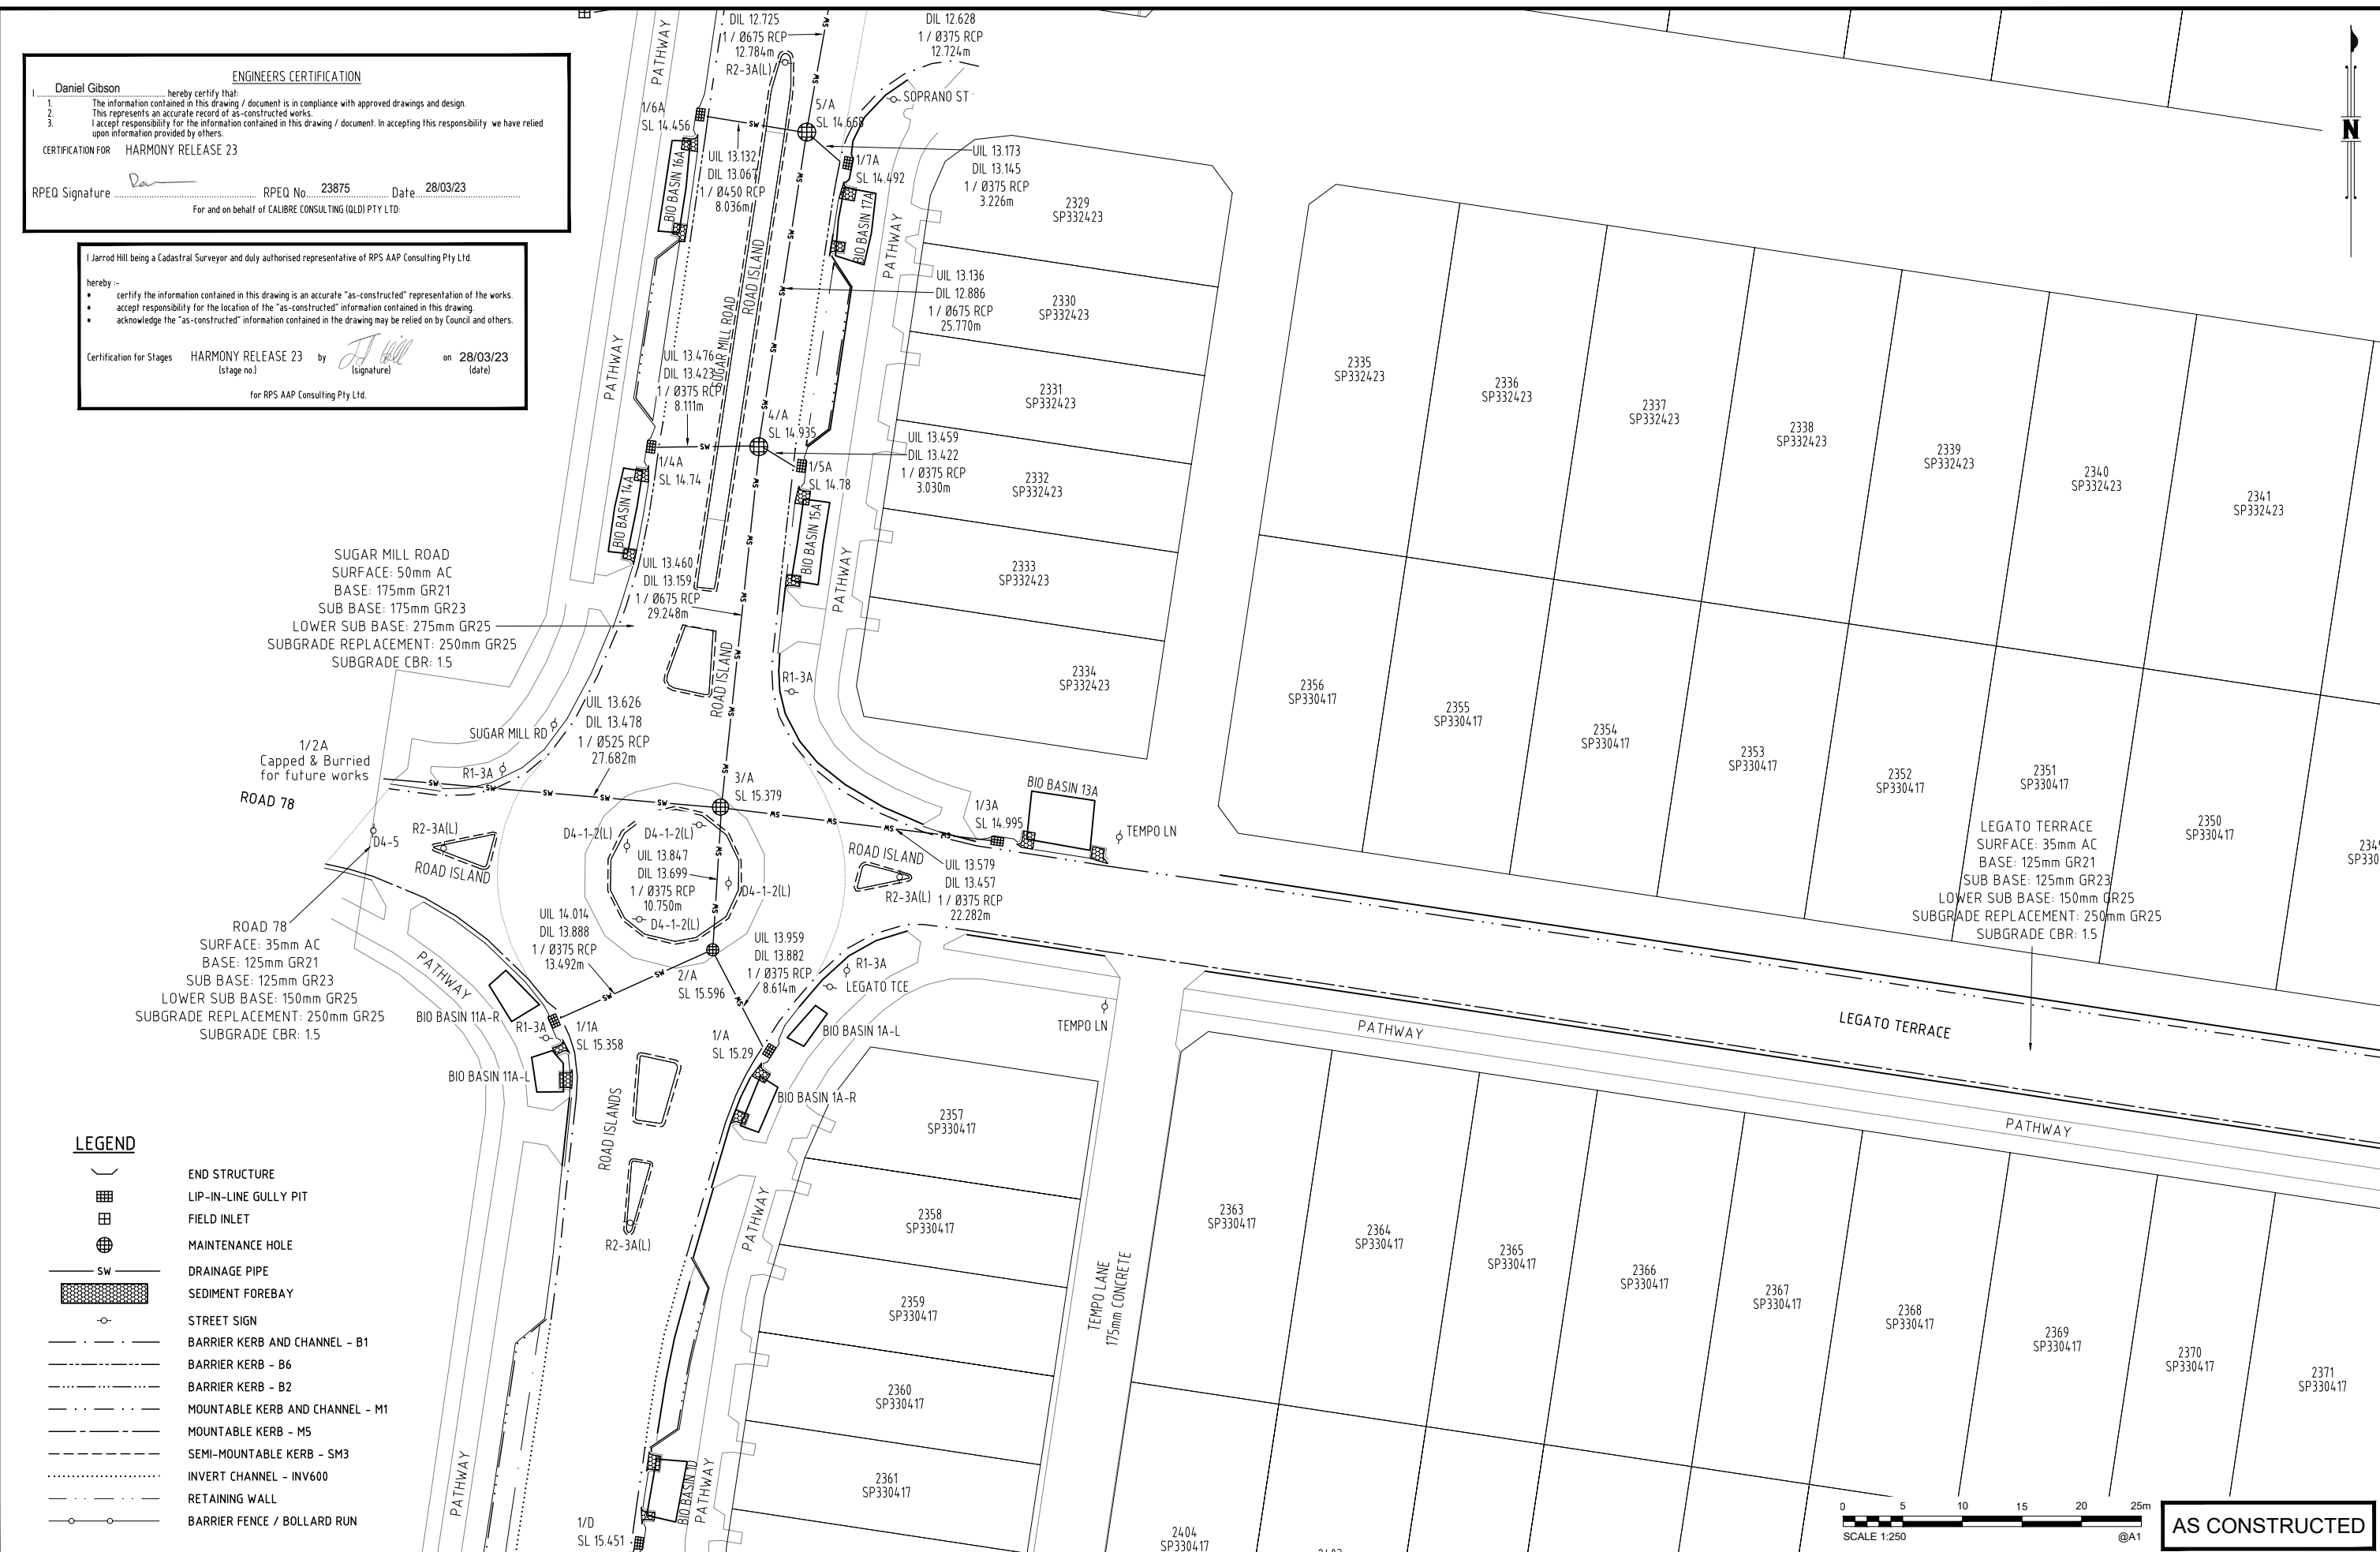


SUGAR MILL ROAD
 SURFACE: 50mm AC
 BASE: 175mm GR21
 SUB BASE: 175mm GR23
 LOWER SUB BASE: 275mm GR25
 SUBGRADE REPLACEMENT: 250mm GR25
 SUBGRADE CBR: 1.5

1/2A
 Capped & Buried
 for future works

ROAD 78
 SURFACE: 35mm AC
 BASE: 125mm GR21
 SUB BASE: 125mm GR23
 LOWER SUB BASE: 150mm GR25
 SUBGRADE REPLACEMENT: 250mm GR25
 SUBGRADE CBR: 1.5

LEGATO TERRACE
 SURFACE: 35mm AC
 BASE: 125mm GR21
 SUB BASE: 125mm GR23
 LOWER SUB BASE: 150mm GR25
 SUBGRADE REPLACEMENT: 250mm GR25
 SUBGRADE CBR: 1.5

- LEGEND**
- END STRUCTURE
 - LIP-IN-LINE GULLY PIT
 - FIELD INLET
 - MAINTENANCE HOLE
 - DRAINAGE PIPE
 - SEDIMENT FOREBAY
 - STREET SIGN
 - BARRIER KERB AND CHANNEL - B1
 - BARRIER KERB - B6
 - BARRIER KERB - B2
 - MOUNTABLE KERB AND CHANNEL - M1
 - MOUNTABLE KERB - M5
 - SEMI-MOUNTABLE KERB - SM3
 - INVERT CHANNEL - INV600
 - RETAINING WALL
 - BARRIER FENCE / BOLLARD RUN

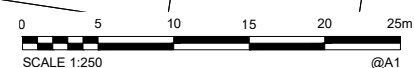

AS CONSTRUCTED

A1	0	24/03/2023	AS-CONSTRUCTED DETAILS	LG	BS
	INDEX	DATE	REVISIONS	DRAWN	CHECKED

DRAWN	LG	24/03/2023
CHECKED	BS	24/03/2023
PASSED		
INITIALS		DATE

Calibre Professional Services Pty Ltd
 Level 4, Unit 401, 8 Market Lane,
 Maroochydore, QLD 4558
 Telephone 07 5314 2520
 Facsimile 07 5314 2522

calibre
 © calibregroup.com

Sunshine Coast COUNCIL

SUNSHINE COAST COUNCIL
 ROADS AND DRAINAGE
 HARMONY - RELEASE 23
 COUNCIL REFERENCE: OPW21/0455.01

SCALE	1:250
SHEET 3	OF 6 SHEETS
DRAWING NO.	



LEGEND

	END STRUCTURE
	LIP-IN-LINE GULLY PIT
	FIELD INLET
	MAINTENANCE HOLE
	DRAINAGE PIPE
	SEDIMENT FOREBAY
	STREET SIGN
	BARRIER KERB AND CHANNEL - B1
	BARRIER KERB - B6
	BARRIER KERB - B2
	MOUNTABLE KERB AND CHANNEL - M1
	MOUNTABLE KERB - M5
	SEMI-MOUNTABLE KERB - SM3
	INVERT CHANNEL - INV600
	RETAINING WALL
	BARRIER FENCE / BOLLARD RUN

ENGINEERS CERTIFICATION

I, Daniel Gibson, hereby certify that:

- The information contained in this drawing / document is in compliance with approved drawings and design.
- This represents an accurate record of as-constructed works.
- I accept responsibility for the information contained in this drawing / document. In accepting this responsibility we have relied upon information provided by others.

CERTIFICATION FOR HARMONY RELEASE 23

RPEQ Signature: *[Signature]* RPEQ No. 23875 Date 28/03/23

For and on behalf of CALIBRE CONSULTING (QLD) PTY LTD:

I Jarrod Hill being a Cadastral Surveyor and duly authorised representative of RPS AAP Consulting Pty Ltd.

hereby :-

- certify the information contained in this drawing is an accurate "as-constructed" representation of the works.
- accept responsibility for the location of the "as-constructed" information contained in this drawing.
- acknowledge the "as-constructed" information contained in the drawing may be relied on by Council and others.

Certification for Stages HARMONY RELEASE 23 by *[Signature]* on 28/03/23 (stage no.) (signature) (date)

for RPS AAP Consulting Pty Ltd.

TENOR STREET
 SURFACE: 35mm AC
 BASE: 125mm GR21
 SUB BASE: 125mm GR23
 LOWER SUB BAS 0
 SUBGRADI 0

2440 SP330417

SCALE 1:250 @A1

AS CONSTRUCTED

A1	0	24/03/2023	AS-CONSTRUCTED DETAILS	LG	BS	
	INDEX	DATE	REVISIONS	DRAWN	CHECKED	PASSED

DRAWN	LG	24/03/2023
CHECKED	BS	24/03/2023
PASSED		
INITIALS		DATE

Calibre Professional Services Pty Ltd
 Level 4, Unit 401, 8 Market Lane,
 Maroochydore, QLD 4558
 Telephone 07 5314 2520
 Facsimile 07 5314 2522

Sunshine Coast
 COUNCIL

SUNSHINE COAST COUNCIL
 ROADS AND DRAINAGE
 HARMONY - RELEASE 23
 COUNCIL REFERENCE: OPW21/0455.01

SCALE	1:250
SHEET	4 OF 6 SHEETS
DRAWING NO.	

ENGINEERS CERTIFICATION

I, Daniel Gibson, hereby certify that:
 1. The information contained in this drawing / document is in compliance with approved drawings and design.
 2. This represents an accurate record of as-constructed works.
 3. I accept responsibility for the information contained in this drawing / document. In accepting this responsibility, we have relied upon information provided by others.

CERTIFICATION FOR HARMONY RELEASE 23

RPEQ Signature: [Signature] RPEQ No. 23875 Date 28/03/23
 For and on behalf of CALIBRE CONSULTING (OLD) PTY LTD.

I Jarrod Hill being a Cadastral Surveyor and duly authorised representative of RPS AAP Consulting Pty Ltd.

hereby -
 • certify the information contained in this drawing is an accurate "as-constructed" representation of the works.
 • accept responsibility for the location of the "as-constructed" information contained in this drawing.
 • acknowledge the "as-constructed" information contained in the drawing may be relied on by Council and others.

Certification for Stages HARMONY RELEASE 23 by [Signature] on 28/03/23 (stage no.) (signature) (date)
 for RPS AAP Consulting Pty Ltd.

SUGAR MILL ROAD
 SURFACE: 50mm AC
 BASE: 175mm GR21
 SUB BASE: 175mm GR23
 LOWER SUB BASE: 275mm GR25
 SUBGRADE REPLACEMENT: 250mm GR25
 SUBGRADE CBR: 15


ROAD 76
 SURFACE: 50mm AC
 BASE: 175mm GR21
 SUB BASE: 175mm GR23
 LOWER SUB BASE: 275mm GR25
 SUBGRADE REPLACEMENT: 250mm GR25
 SUBGRADE CBR: 15

1/8D Burried (Future works)
 UIL 13.402 DIL 13.368
 1 / Ø525 RCP 4.315m
 Temp SL 14.716

5/7D
 UIL 13.266 DIL 13.226
 1 / Ø750 RCP 9.301m

UIL 13.445 DIL 13.433
 1 / Ø525 RCP 4.033m


1/9D Burried (Future works)

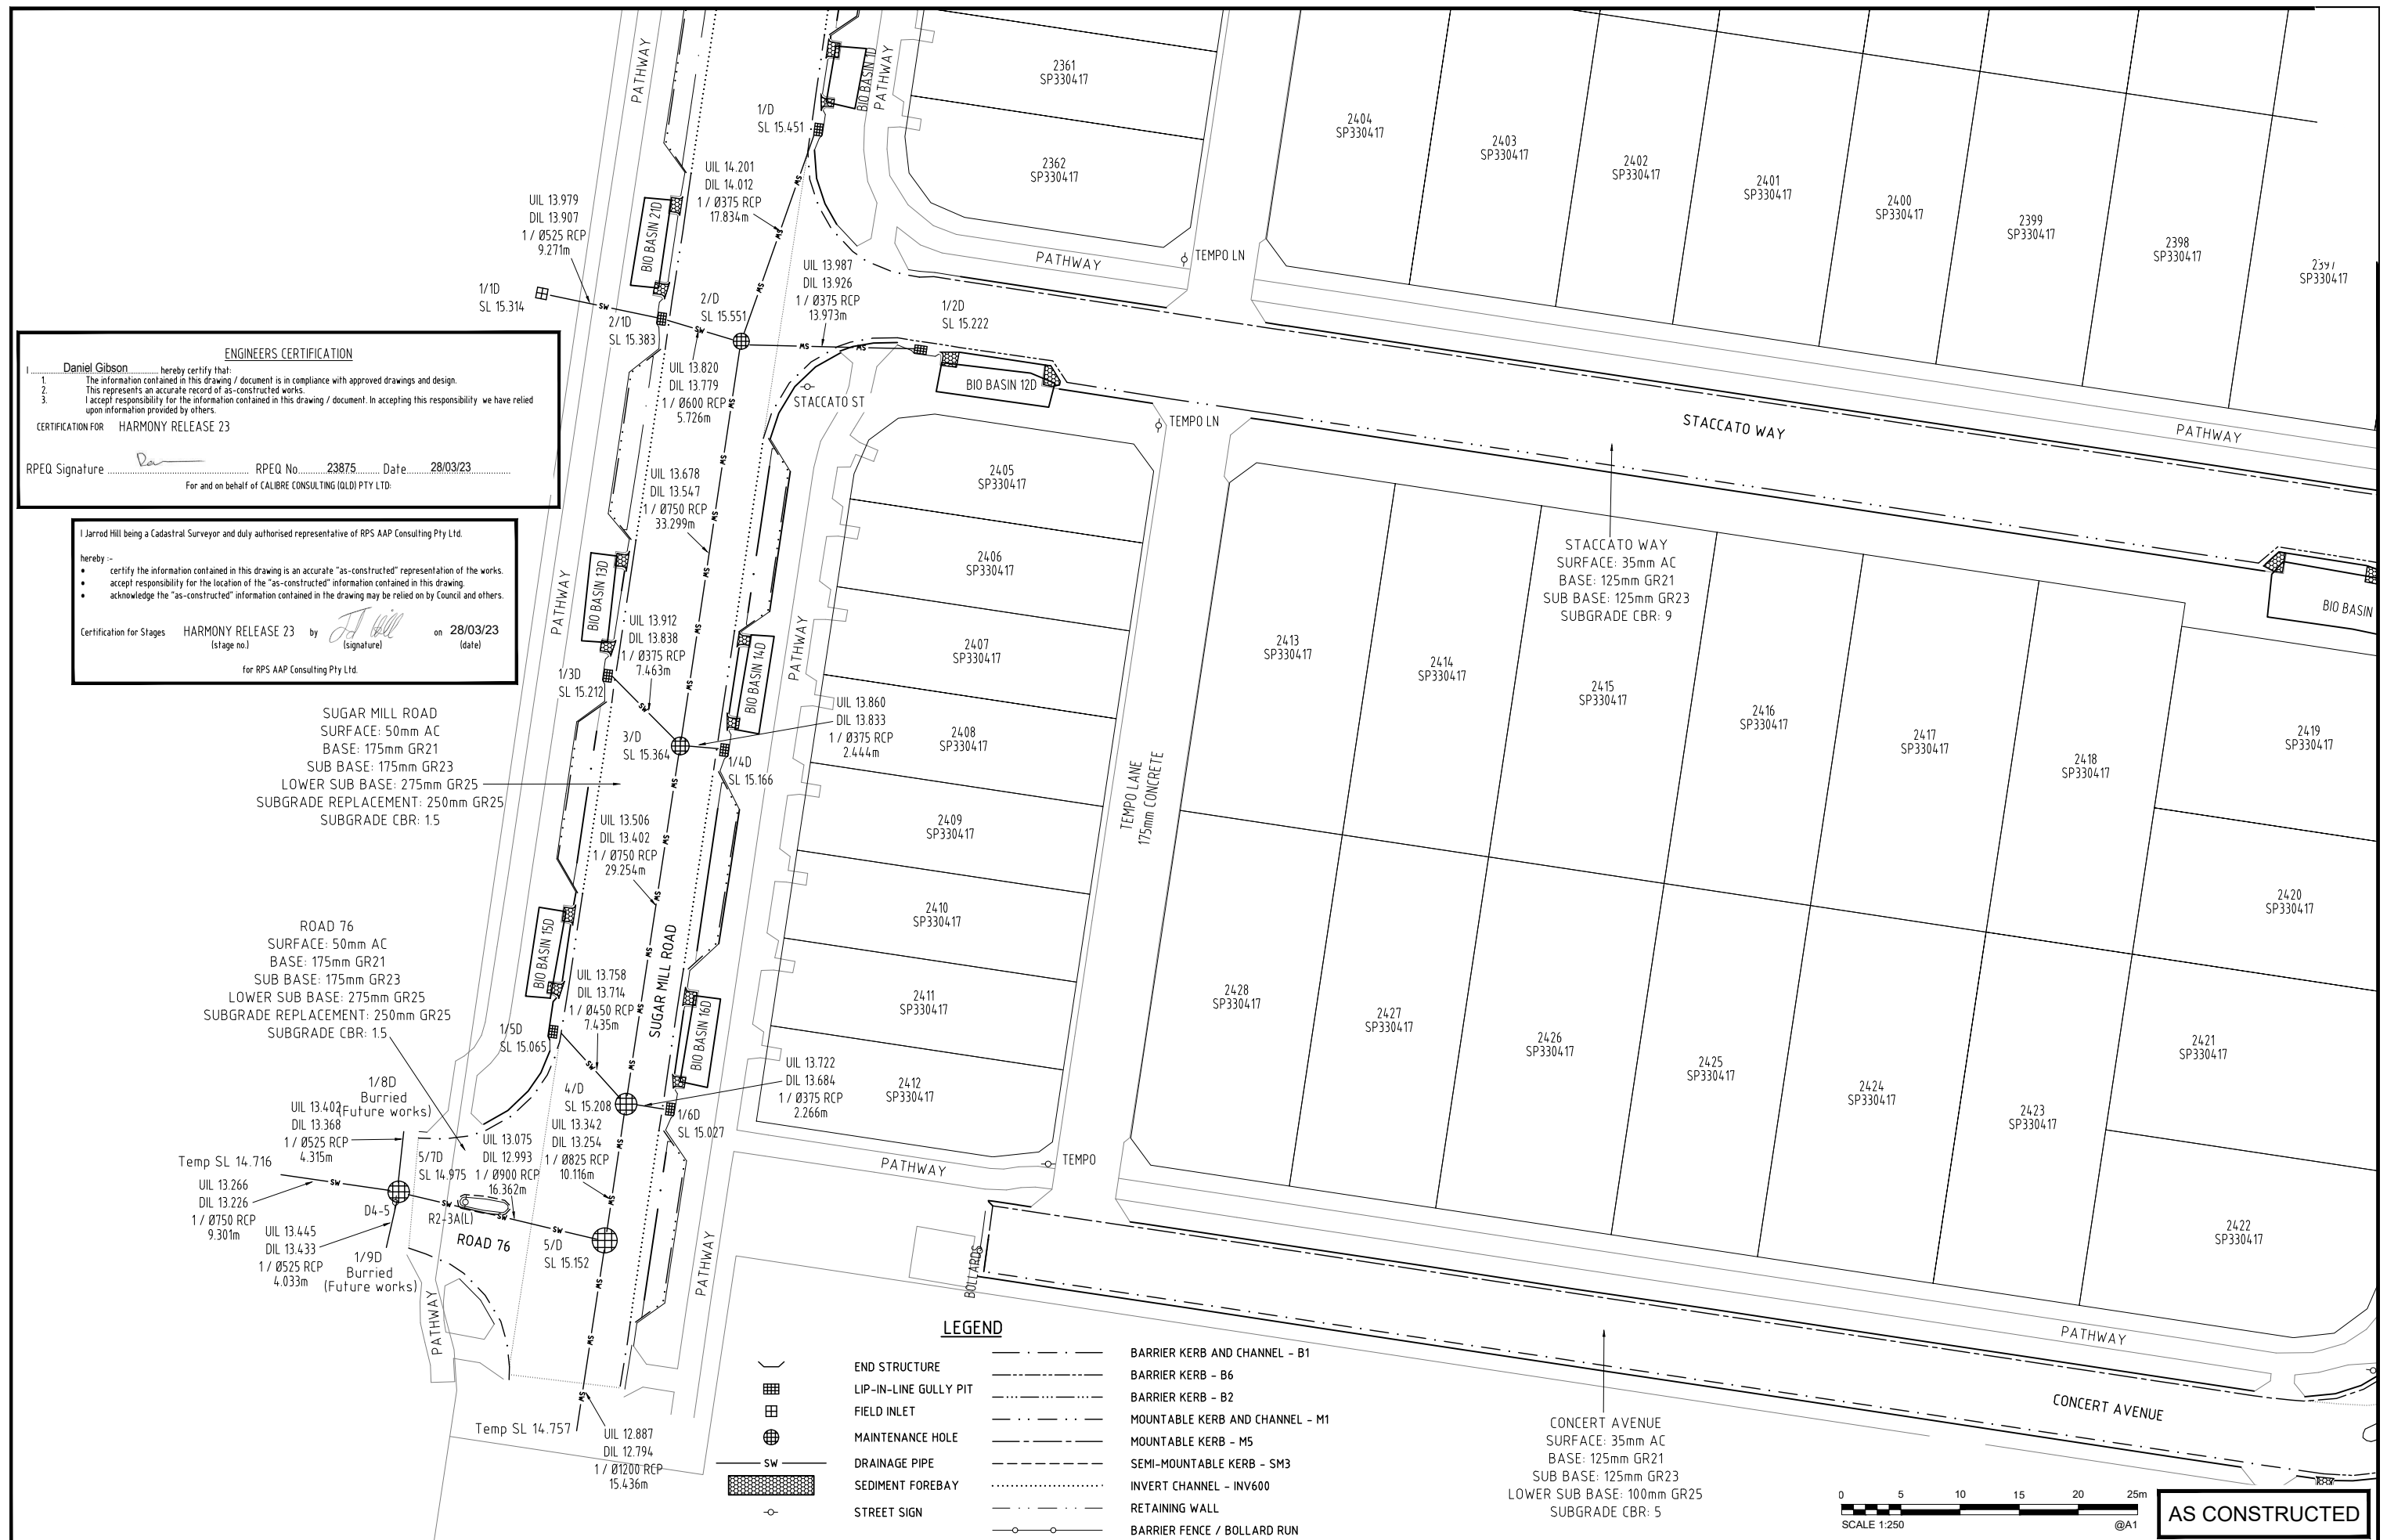

LEGEND

(Symbol)	END STRUCTURE	(Symbol)	BARRIER KERB AND CHANNEL - B1
(Symbol)	LIP-IN-LINE GULLY PIT	(Symbol)	BARRIER KERB - B6
(Symbol)	FIELD INLET	(Symbol)	BARRIER KERB - B2
(Symbol)	MAINTENANCE HOLE	(Symbol)	MOUNTABLE KERB AND CHANNEL - M1
(Symbol)	DRAINAGE PIPE	(Symbol)	MOUNTABLE KERB - M5
(Symbol)	SEDIMENT FOREBAY	(Symbol)	SEMI-MOUNTABLE KERB - SM3
(Symbol)	STREET SIGN	(Symbol)	INVERT CHANNEL - INV600
(Symbol)		(Symbol)	RETAINING WALL
		(Symbol)	BARRIER FENCE / BOLLARD RUN

CONCERT AVENUE
 SURFACE: 35mm AC
 BASE: 125mm GR21
 SUB BASE: 125mm GR23
 LOWER SUB BASE: 100mm GR25
 SUBGRADE CBR: 5

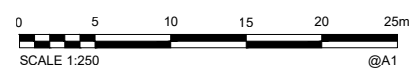

AS CONSTRUCTED

A1	0	24/03/2023	AS-CONSTRUCTED DETAILS	LG	BS
	INDEX	DATE	REVISIONS	DRAWN	CHECKED

DRAWN	LG	24/03/2023
CHECKED	BS	24/03/2023
PASSED		
INITIALS	DATE	


Calibre Professional Services Pty Ltd
 Level 4, Unit 401, 8 Market Lane,
 Maroochydore, QLD 4558
 Telephone 07 5314 2520
 Facsimile 07 5314 2522

calibre
 © calibregroup.com

Sunshine Coast COUNCIL

SUNSHINE COAST COUNCIL
 ROADS AND DRAINAGE
 HARMONY - RELEASE 23
 COUNCIL REFERENCE: OPW21/0455.01

SCALE	1:250
SHEET	5 OF 6 SHEETS
DRAWING NO.	

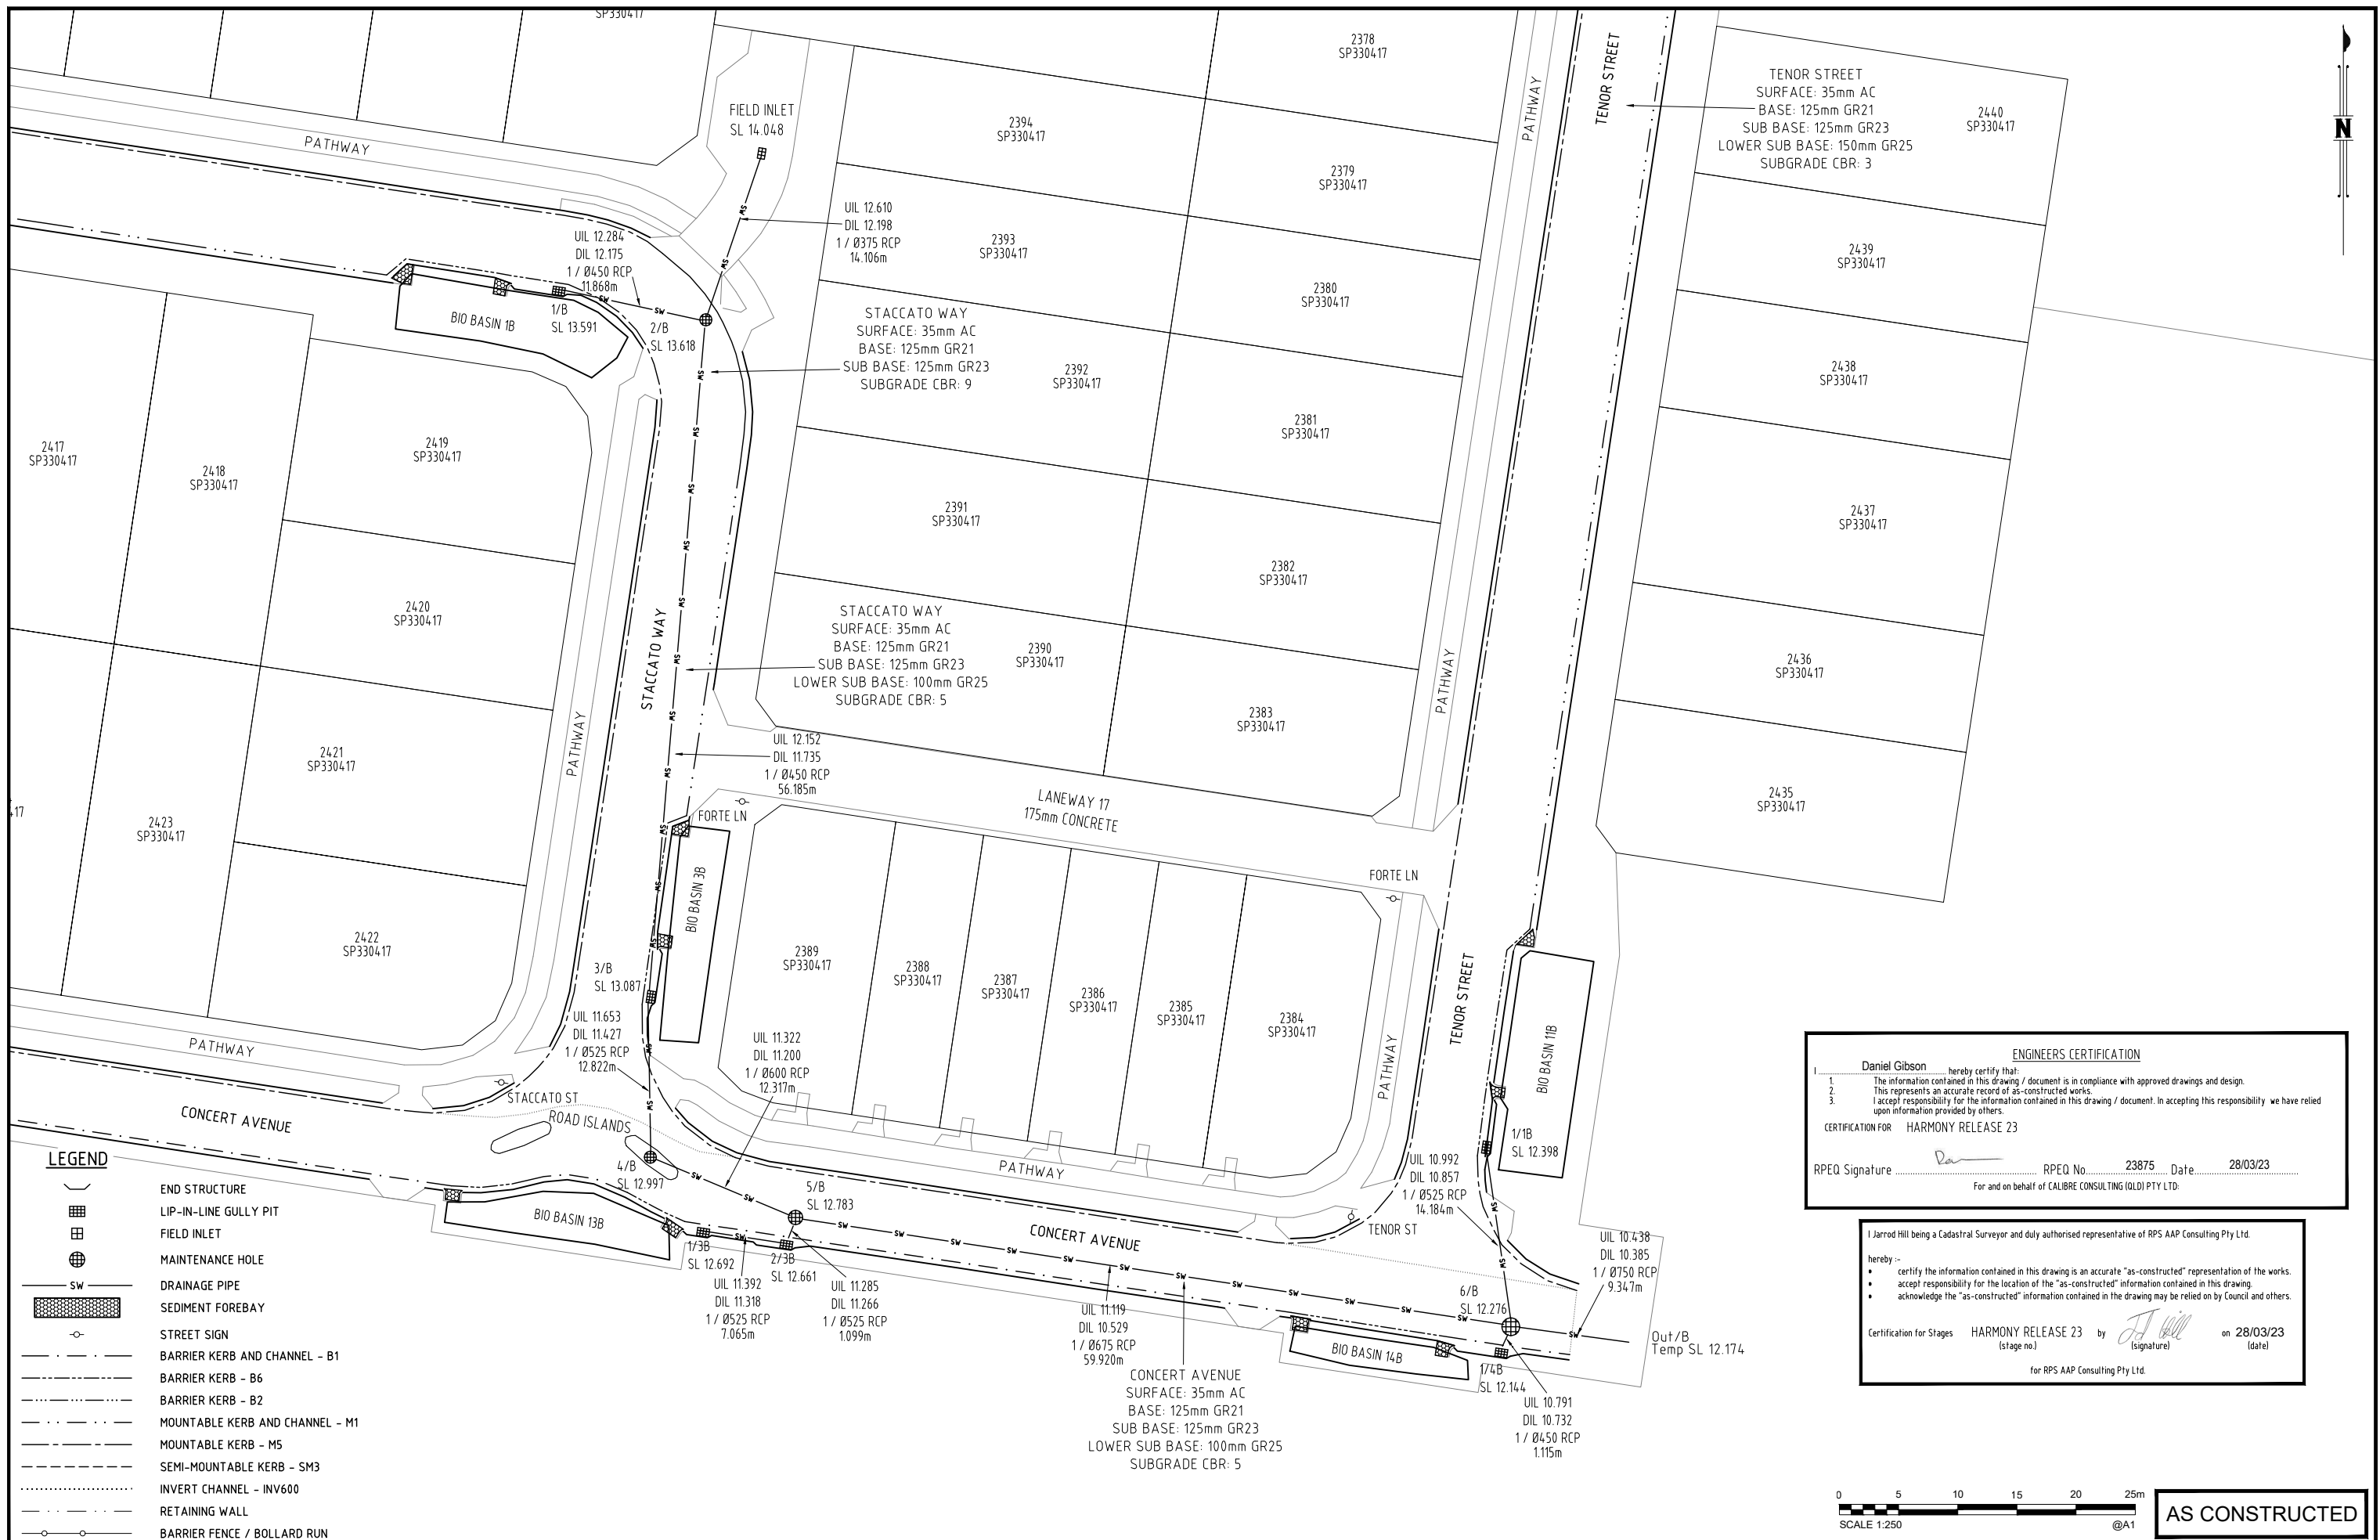

LEGEND

[Symbol]	END STRUCTURE
[Symbol]	LIP-IN-LINE GULLY PIT
[Symbol]	FIELD INLET
[Symbol]	MAINTENANCE HOLE
[Symbol]	DRAINAGE PIPE
[Symbol]	SEDIMENT FOREBAY
[Symbol]	STREET SIGN
[Symbol]	BARRIER KERB AND CHANNEL - B1
[Symbol]	BARRIER KERB - B6
[Symbol]	BARRIER KERB - B2
[Symbol]	MOUNTABLE KERB AND CHANNEL - M1
[Symbol]	MOUNTABLE KERB - M5
[Symbol]	SEMI-MOUNTABLE KERB - SM3
[Symbol]	INVERT CHANNEL - INV600
[Symbol]	RETAINING WALL
[Symbol]	BARRIER FENCE / BOLLARD RUN

ENGINEERS CERTIFICATION

I, Daniel Gibson, hereby certify that:

- The information contained in this drawing / document is in compliance with approved drawings and design.
- This represents an accurate record of as-constructed works.
- I accept responsibility for the information contained in this drawing / document. In accepting this responsibility we have relied upon information provided by others.

CERTIFICATION FOR HARMONY RELEASE 23

RPEQ Signature: *[Signature]* RPEQ No. 23875 Date 28/03/23

For and on behalf of CALIBRE CONSULTING (QLD) PTY LTD.

I, Jarrod Hill being a Cadastral Surveyor and duly authorised representative of RPS AAP Consulting Pty Ltd. hereby:-

- certify the information contained in this drawing is an accurate "as-constructed" representation of the works.
- accept responsibility for the location of the "as-constructed" information contained in this drawing.
- acknowledge the "as-constructed" information contained in the drawing may be relied on by Council and others.

Certification for Stages HARMONY RELEASE 23 (stage no.) by *[Signature]* on 28/03/23 (date)

for RPS AAP Consulting Pty Ltd.

0 5 10 15 20 25m
SCALE 1:250 @A1

AS CONSTRUCTED

A1	0	24/03/2023	AS-CONSTRUCTED DETAILS	LG	BS				Calibre Professional Services Pty Ltd Level 4, Unit 401, 8 Market Lane, Maroochydore, QLD 4558 Telephone 07 5314 2520 Facsimile 07 5314 2522		SUNSHINE COAST COUNCIL ROADS AND DRAINAGE HARMONY - RELEASE 23 COUNCIL REFERENCE: OPW21/04.55.01	SCALE 1:250
	INDEX	DATE	REVISIONS	DRAWN	CHECKED	PASSED	DRAWN	CHECKED				PASSED