

 

 

 
 



 

 



LEGEND

-  END STRUCTURE
-  LIP-IN-LINE GULLY PIT
-  FIELD INLET
-  MAINTENANCE HOLE
-  DRAINAGE PIPE
-  SEDIMENT FOREBAY
-  STREET SIGN
-  BARRIER KERB AND CHANNEL - B1
-  BARRIER KERB - B6
-  BARRIER KERB - B2
-  MOUNTABLE KERB AND CHANNEL - M1
-  MOUNTABLE KERB - M4
-  MOUNTABLE KERB - M5
-  SEMI-MOUNTABLE KERB - SM3
-  INVERT CHANNEL - INV600/INV900

ENGINEERS CERTIFICATION

Daniel Gibson hereby certify that:
 1. The information contained in this drawing / document is in compliance with approved drawings and design.
 2. This represents an accurate record of as-constructed works.
 3. I accept responsibility for the information contained in this drawing / document. In accepting this responsibility we have relied upon information provided by others.



CERTIFICATION FOR HARMONY RELEASE 24

RPEQ Signature: *[Signature]* RPEQ No. 23875 Date: 02-08-2023
 For and on behalf of EGIS CONSULTING (QLD) PTY LTD.

I Jarrod Hill being a Cadastral Surveyor and duly authorised representative of RPS AAP Consulting Pty Ltd. hereby:-

- certify the information contained in this drawing is an accurate "as-constructed" representation of the works.
- accept responsibility for the location of the "as-constructed" information contained in this drawing.
- acknowledge the "as-constructed" information contained in the drawing may be relied on by Council and others.

Certification for Stages HARMONY RELEASE 24 by *[Signature]* on 26.07.23
 (stage no.) (signature) (date)
 for RPS AAP Consulting Pty Ltd.

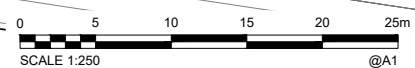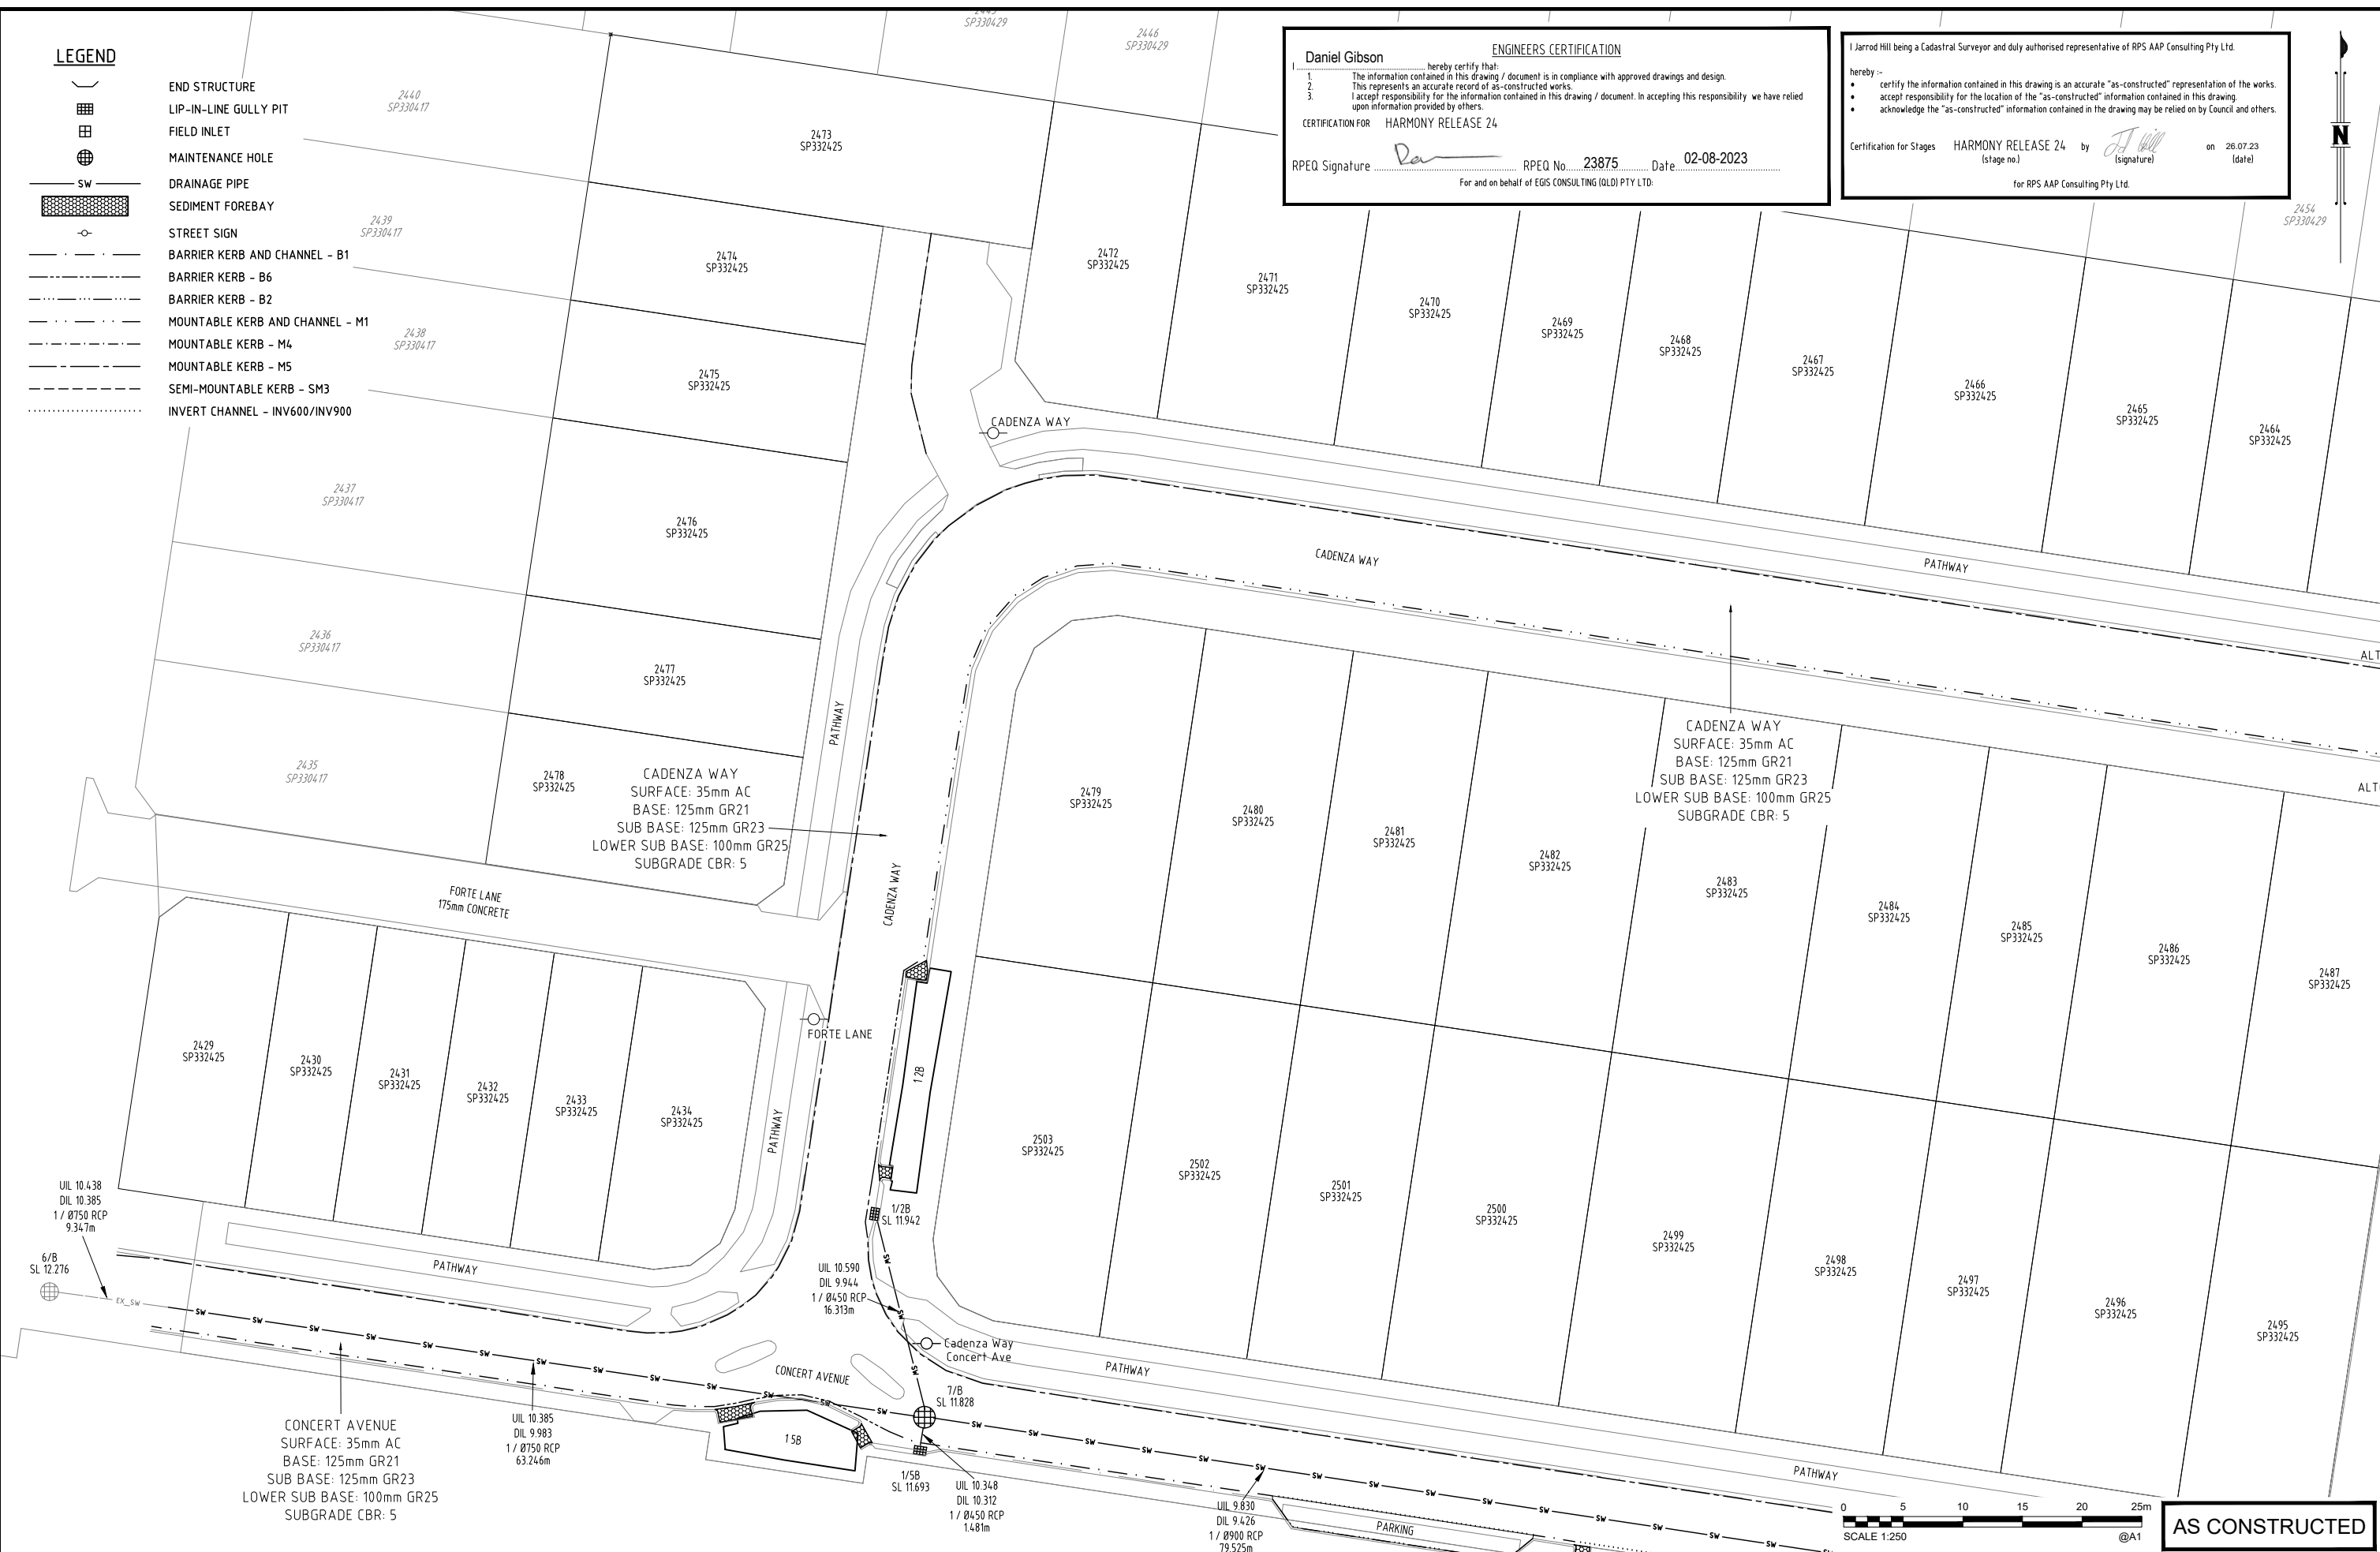

AS CONSTRUCTED

A1	0	26/07/2023	AS-CONSTRUCTED DETAILS	LG	BS
	INDEX	DATE	REVISIONS	DRAWN	CHECKED

DRAWN	LG	26/07/2023
CHECKED	BS	26/07/2023
PASSED		
INITIALS		DATE



EGIS CONSULTING Pty Ltd
 Level 4, Unit 401, 8 Market Lane,
 Maroochydore, QLD 4558
 Telephone 07 5314 2520
 Facsimile 07 5314 2522



Sunshine Coast
 COUNCIL

SUNSHINE COAST COUNCIL

ROADS AND DRAINAGE
 HARMONY - RELEASE 24
 COUNCIL REFERENCE: OPW21/0640

SCALE	1:250
SHEET 1	OF 3 SHEETS
DRAWING NO.	


Daniel Gibson ENGINEERS CERTIFICATION
 I, Daniel Gibson, hereby certify that:
 1. The information contained in this drawing / document is in compliance with approved drawings and design.
 2. This represents an accurate record of as-constructed works.
 3. I accept responsibility for the information contained in this drawing / document. In accepting this responsibility we have relied upon information provided by others.
 CERTIFICATION FOR HARMONY RELEASE 24
 RPEQ Signature: *D Gibson* RPEQ No. 23875 Date 02-08-2023
 For and on behalf of EGIS CONSULTING (QLD) PTY LTD.

I Jarrod Hill being a Cadastral Surveyor and duly authorised representative of RPS AAP Consulting Pty Ltd.
 hereby :-
 • certify the information contained in this drawing is an accurate "as-constructed" representation of the works.
 • accept responsibility for the location of the "as-constructed" information contained in this drawing
 • acknowledge the "as-constructed" information contained in the drawing may be relied on by Council and others.
 Certification for Stages HARMONY RELEASE 24 by *J Hill* on 26.07.23
 (stage no.) (signature) (date)
 for RPS AAP Consulting Pty Ltd.

VANTAGE WAY
 SURFACE: 50mm AC
 BASE: 125mm GR21
 SUB BASE: 125mm GR23
 LOWER SUB BASE: 400mm GR25
 SUBGRADE REPLACEMENT: 250mm GR25
 SUBGRADE CBR: 3

ROAD 48
 SURFACE: 50mm AC
 BASE: 125mm GR21
 SUB BASE: 125mm GR23
 LOWER SUB BASE: 400mm GR25
 SUBGRADE REPLACEMENT: 250mm GR25
 SUBGRADE CBR: 3

CADENZA WAY
 SURFACE: 35mm AC
 BASE: 125mm GR21
 SUB BASE: 125mm GR23
 LOWER SUB BASE: 100mm GR25
 SUBGRADE CBR: 5

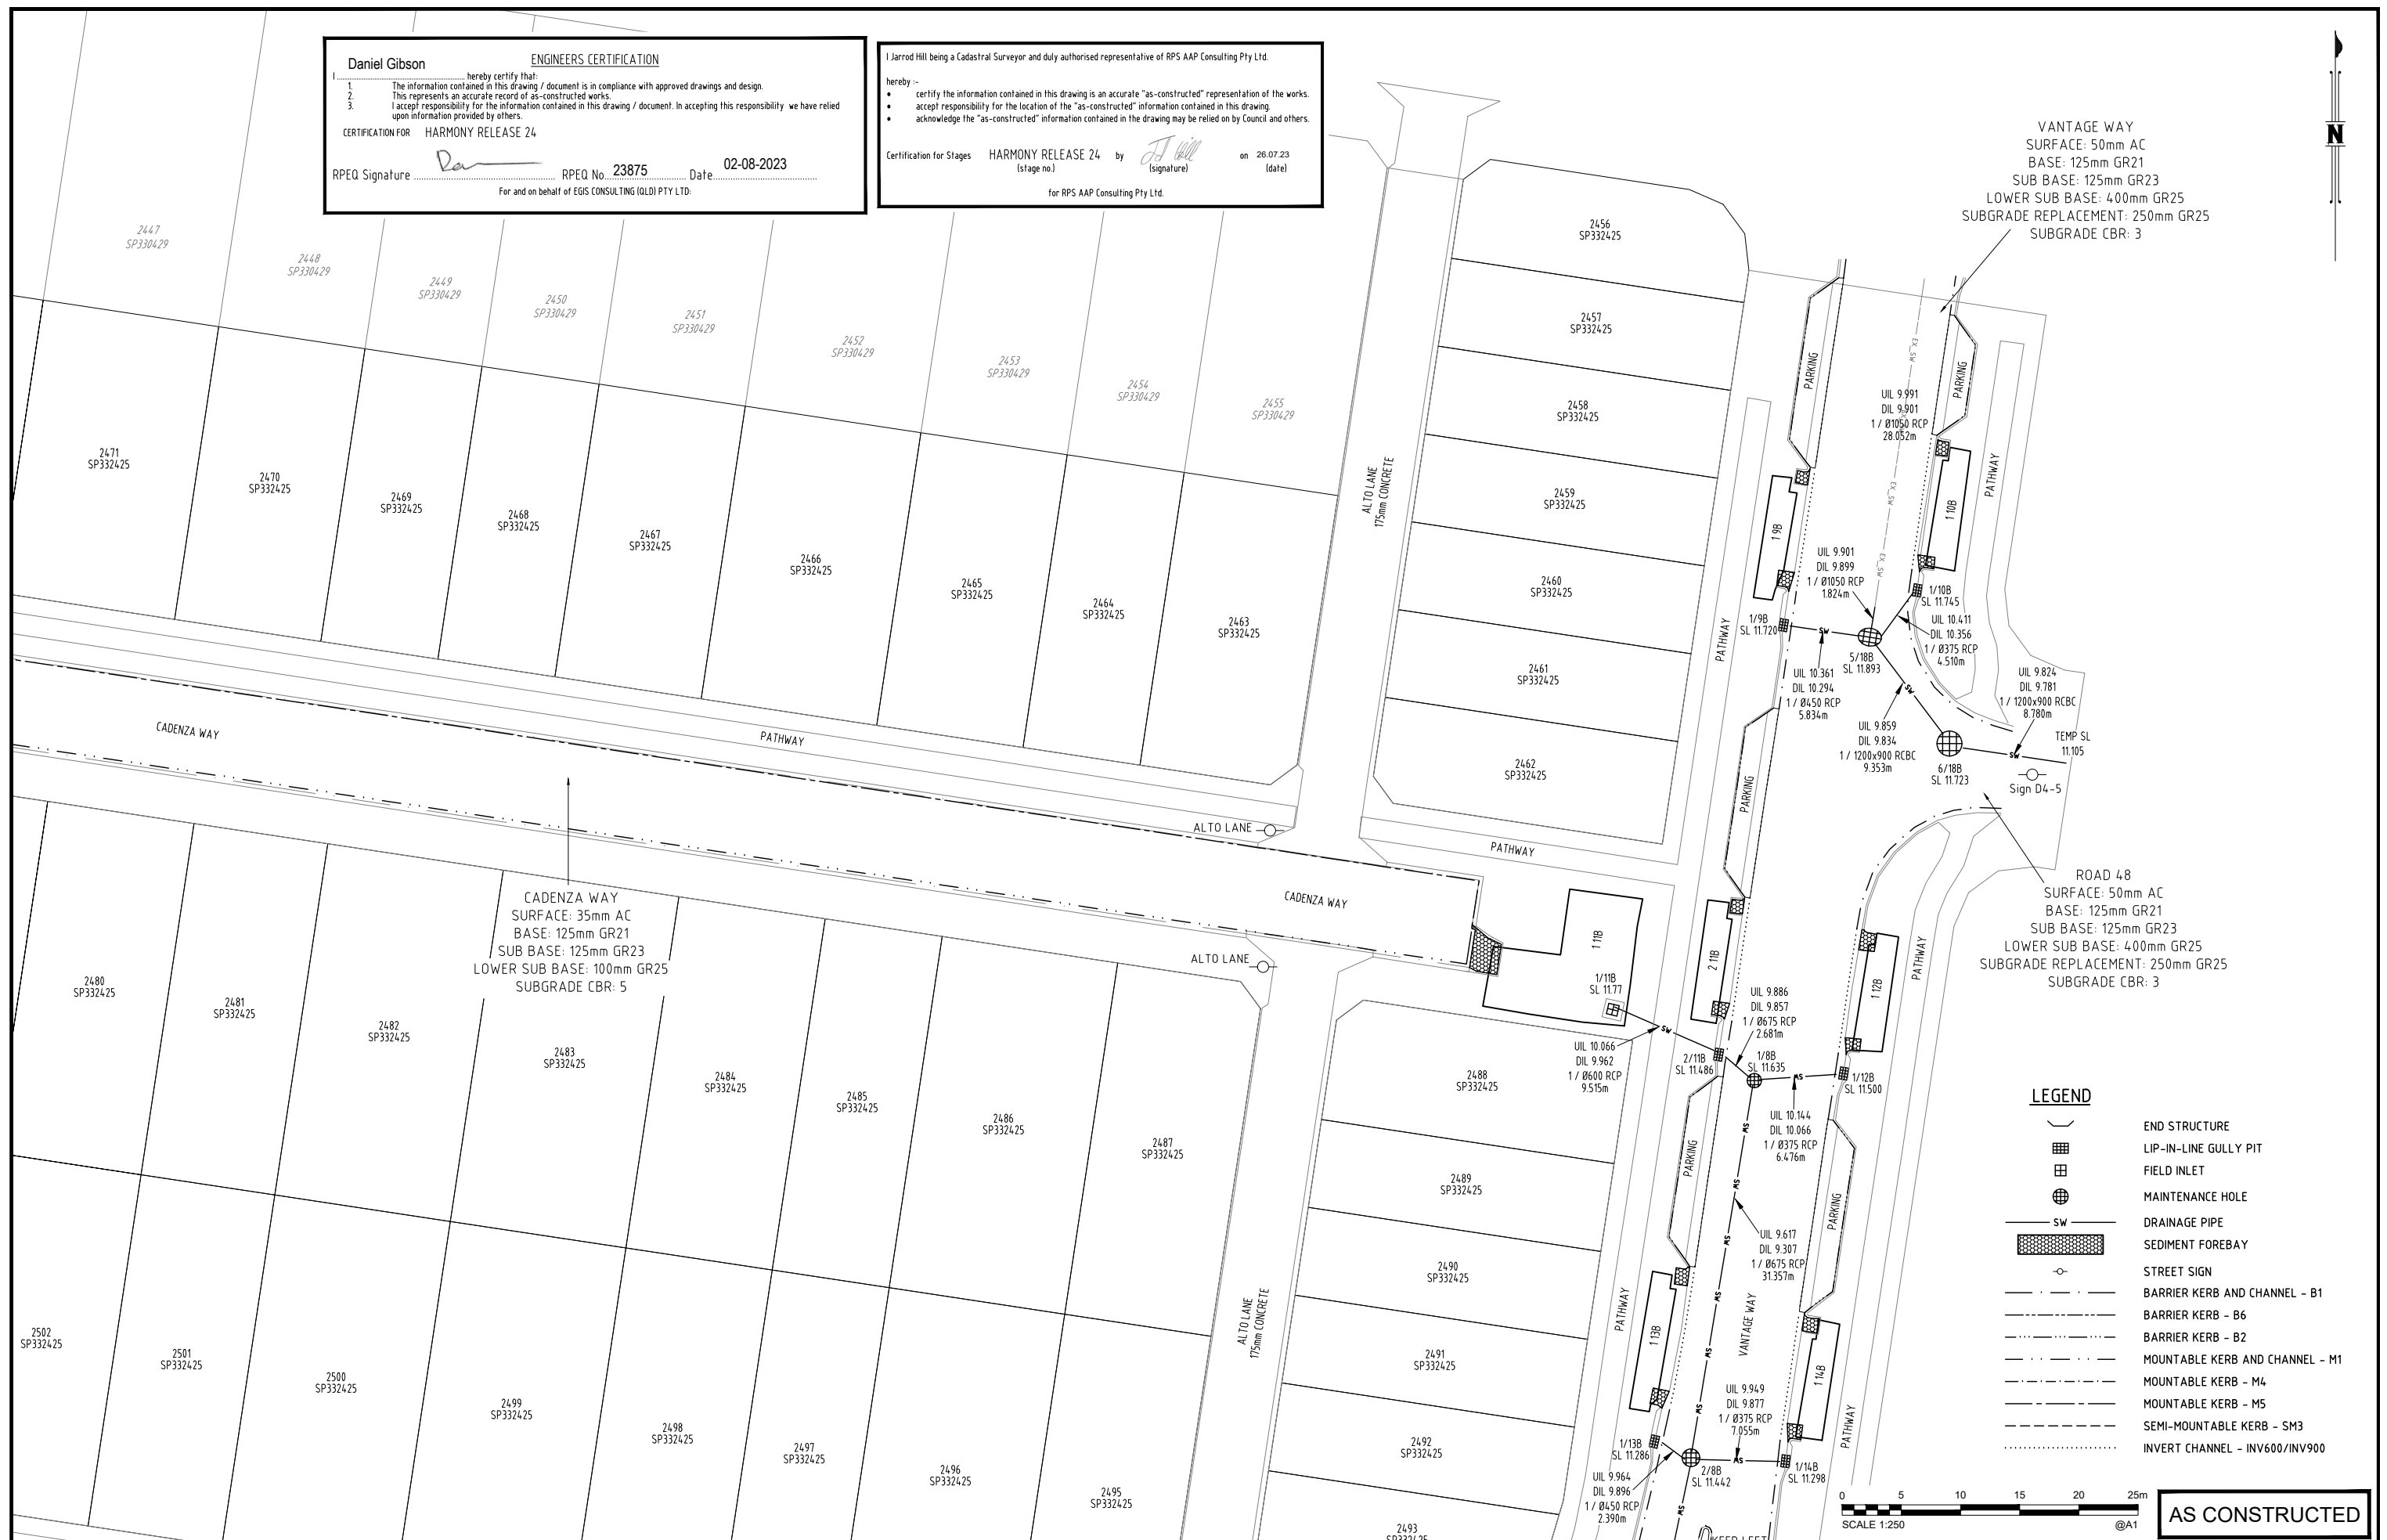


A1	0	26/07/2023	AS-CONSTRUCTED DETAILS	LG	BS
	INDEX	DATE	REVISIONS	DRAWN	CHECKED

DRAWN	LG	26/07/2023
CHECKED	BS	26/07/2023
PASSED		
INITIALS	DATE	



SUNSHINE COAST COUNCIL		SCALE 1:250
ROADS AND DRAINAGE HARMONY - RELEASE 24 COUNCIL REFERENCE: OPW21/0640		SHEET 2 OF 3 SHEETS
		DRAWING NO.

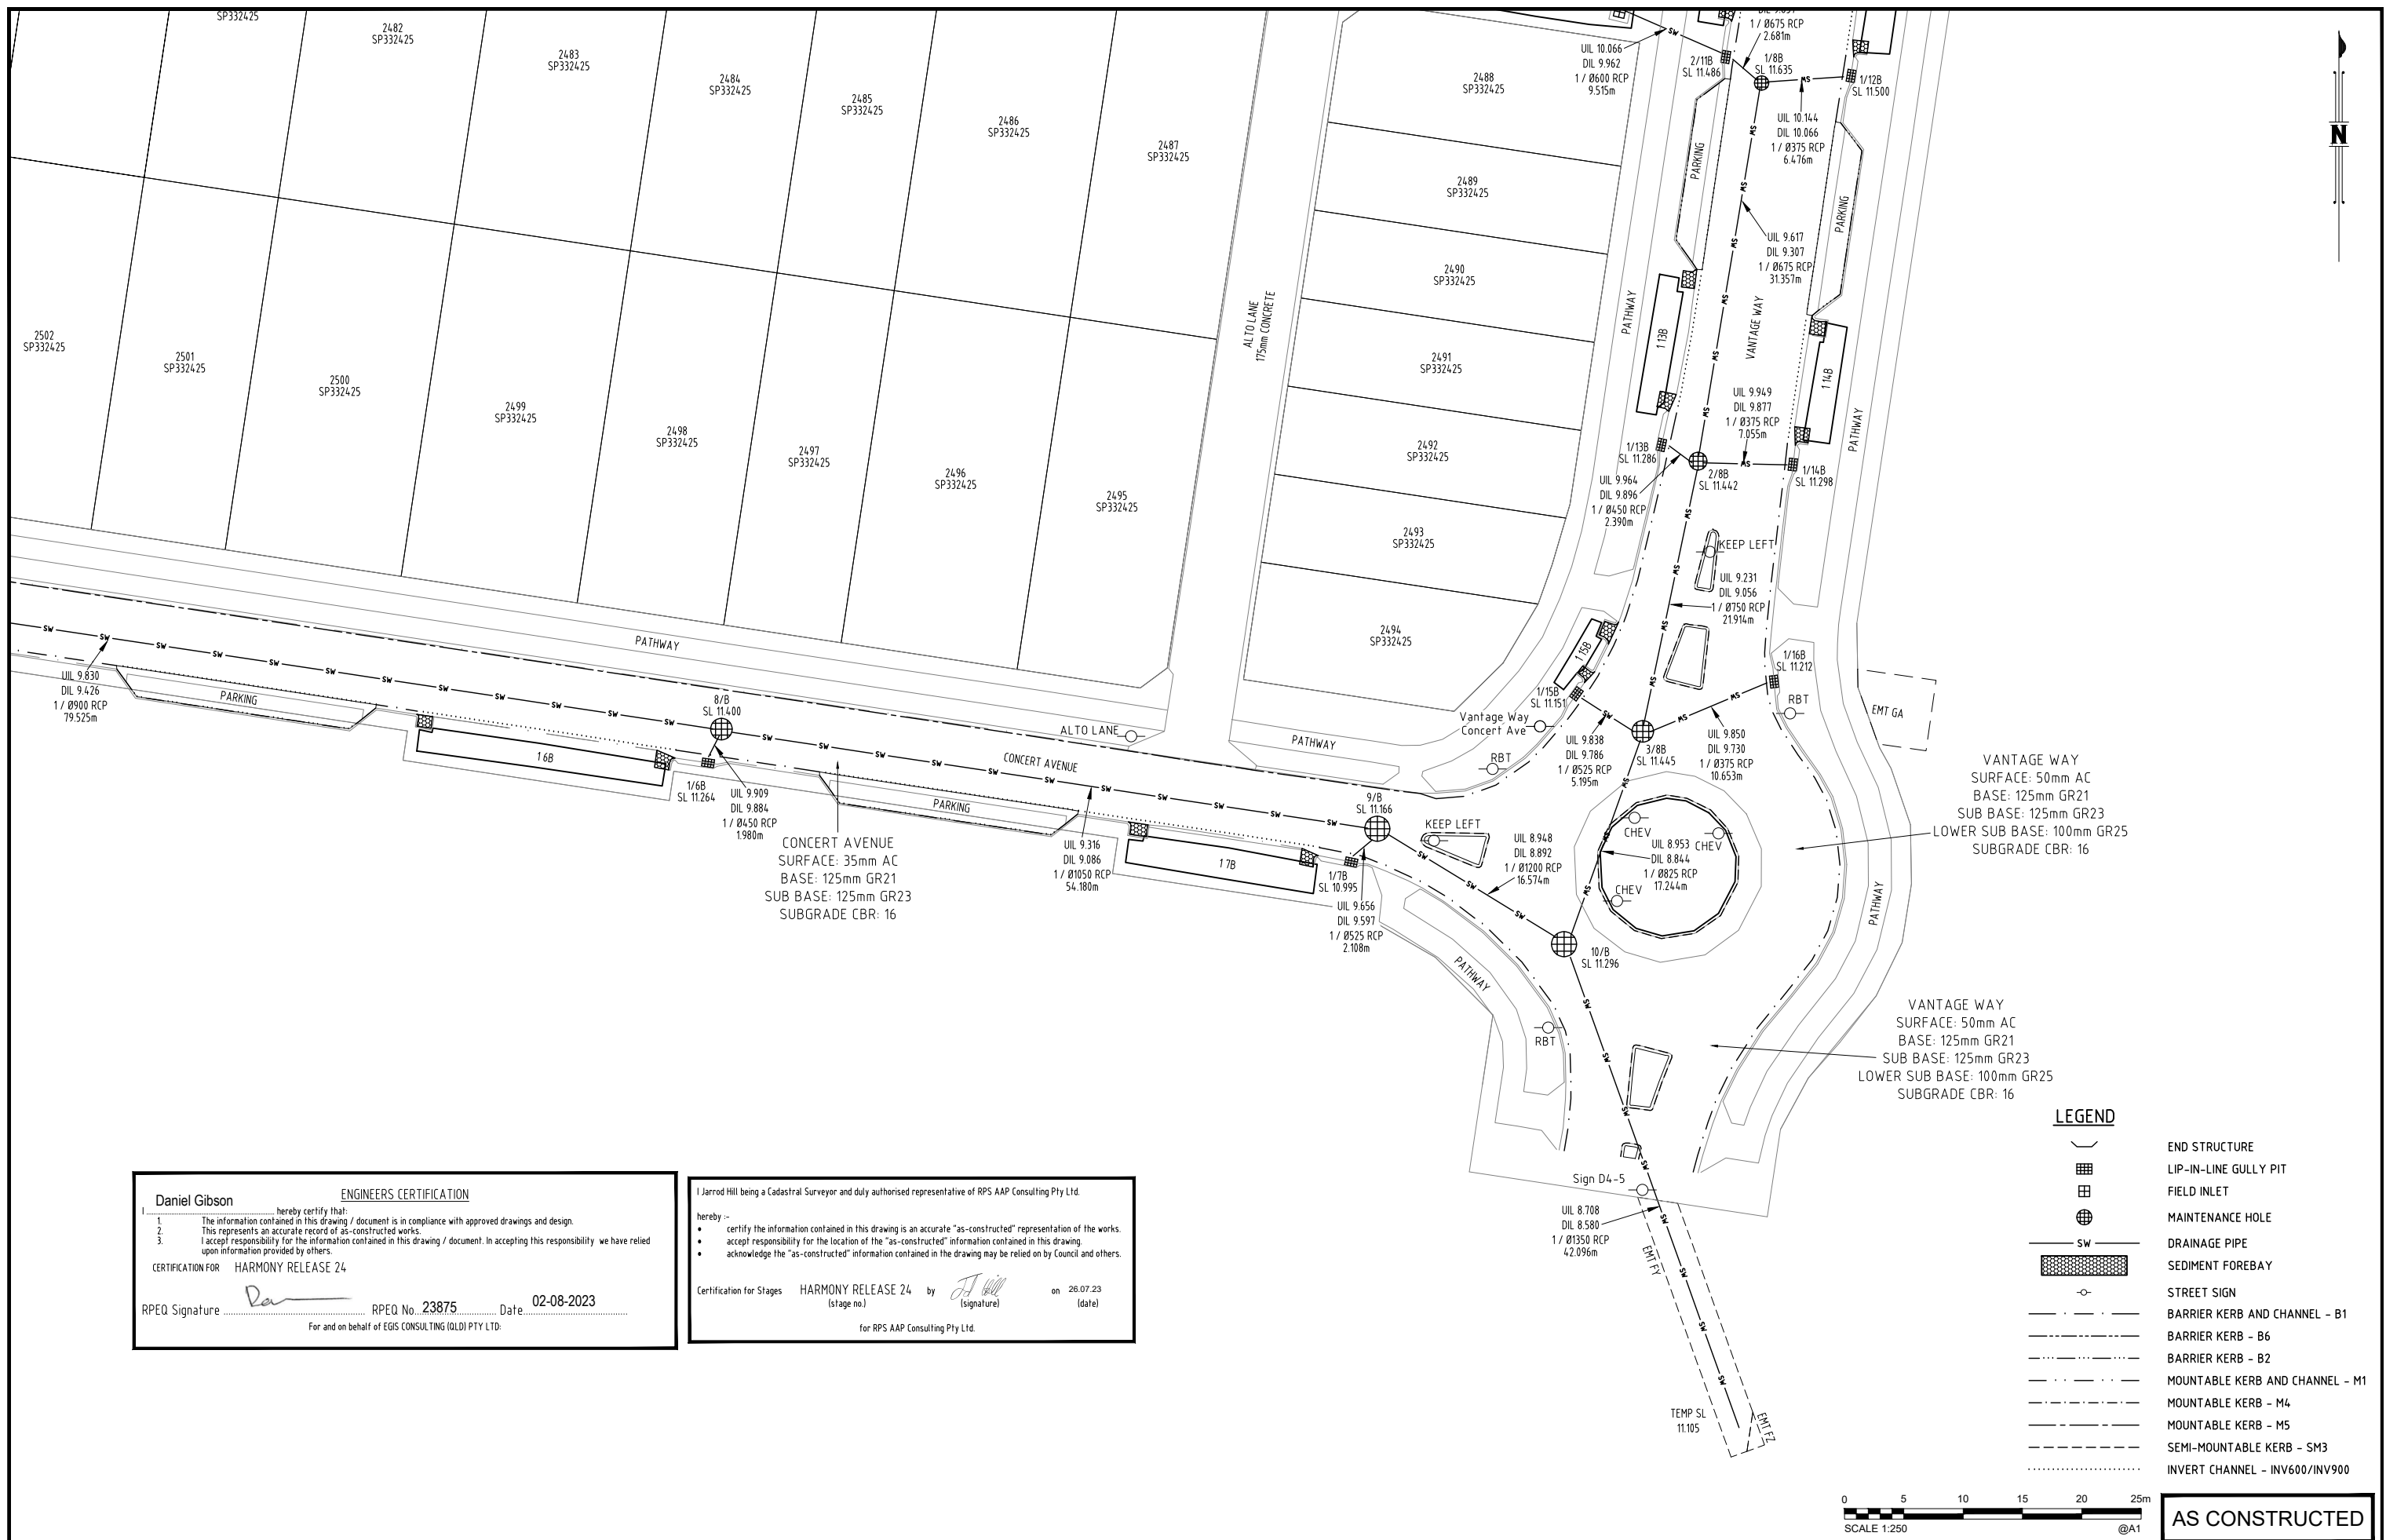

Daniel Gibson ENGINEERS CERTIFICATION

I, Daniel Gibson, hereby certify that:
 1. The information contained in this drawing / document is in compliance with approved drawings and design.
 2. This represents an accurate record of as-constructed works.
 3. I accept responsibility for the information contained in this drawing / document. In accepting this responsibility we have relied upon information provided by others.

CERTIFICATION FOR HARMONY RELEASE 24

RPEQ Signature: *[Signature]* RPEQ No. 23875 Date: 02-08-2023

For and on behalf of EGIS CONSULTING (QLD) PTY LTD.

I Jarrod Hill being a Cadastral Surveyor and duly authorised representative of RPS AAP Consulting Pty Ltd.

hereby:-

- certify the information contained in this drawing is an accurate "as-constructed" representation of the works.
- accept responsibility for the location of the "as-constructed" information contained in this drawing.
- acknowledge the "as-constructed" information contained in the drawing may be relied on by Council and others.

Certification for Stages HARMONY RELEASE 24 by *[Signature]* on 26.07.23 (stage no.) (signature) (date)

for RPS AAP Consulting Pty Ltd.

- LEGEND**
- END STRUCTURE
 - LIP-IN-LINE GULLY PIT
 - FIELD INLET
 - MAINTENANCE HOLE
 - DRAINAGE PIPE
 - SEDIMENT FOREBAY
 - STREET SIGN
 - BARRIER KERB AND CHANNEL - B1
 - BARRIER KERB - B6
 - BARRIER KERB - B2
 - MOUNTABLE KERB AND CHANNEL - M1
 - MOUNTABLE KERB - M4
 - MOUNTABLE KERB - M5
 - SEMI-MOUNTABLE KERB - SM3
 - INVERT CHANNEL - INV600/INV900



AS CONSTRUCTED

A1	0	26/07/2023	AS-CONSTRUCTED DETAILS	LG	BS	
	INDEX	DATE	REVISIONS	DRAWN	CHECKED	PASSED

DRAWN	LG	26/07/2023
CHECKED	BS	26/07/2023
PASSED		
INITIALS		DATE



EGIS CONSULTING Pty Ltd
 Level 4, Unit 401, 8 Market Lane,
 Maroochydore, QLD 4558
 Telephone 07 5314 2520
 Facsimile 07 5314 2522



SUNSHINE COAST COUNCIL
 ROADS AND DRAINAGE
 HARMONY - RELEASE 24
 COUNCIL REFERENCE: OPW21/0640

SCALE	1:250
SHEET 3	OF 3 SHEETS
DRAWING NO.	