 

 

 
 

 
 
 



 




**LEGEND**


-  END STRUCTURE
-  LIP-IN-LINE GULLY PIT
-  FIELD INLET
-  MAINTENANCE HOLE
-  DRAINAGE PIPE
-  SEDIMENT FOREBAY
-  STREET SIGN
-  BARRIER KERB AND CHANNEL - B1
-  BARRIER KERB - B6
-  BARRIER KERB - B2
-  MOUNTABLE KERB AND CHANNEL - M1
-  MOUNTABLE KERB - M4
-  MOUNTABLE KERB - M5
-  SEMI-MOUNTABLE KERB - SM3
-  INVERT CHANNEL
-  BOLLARD RUN

**ENGINEERS CERTIFICATION**

Daniel Gibson hereby certify that:

1. The information contained in this drawing / document is in compliance with approved drawings and design.
2. This represents an accurate record of as-constructed works.
3. I accept responsibility for the information contained in this drawing / document. In accepting this responsibility we have relied upon information provided by others.

CERTIFICATION FOR HARMONY RELEASE 22


RPEQ Signature  RPEQ No. 23875 Date 13-07-2023

For and on behalf of EGIS CONSULTING (QLD) PTY LTD.


I Jarrod Hill being a Cadastral Surveyor and duly authorised representative of RPS AAP Consulting Pty Ltd.

hereby:-

- certify the information contained in this drawing is an accurate "as-constructed" representation of the works.
- accept responsibility for the location of the "as-constructed" information contained in this drawing.
- acknowledge the "as-constructed" information contained in the drawing may be relied on by Council and others.

Certification for Stages HARMONY RELEASE 22 by  on 12/07/23 (stage no.) (signature) (date)

for RPS AAP Consulting Pty Ltd.

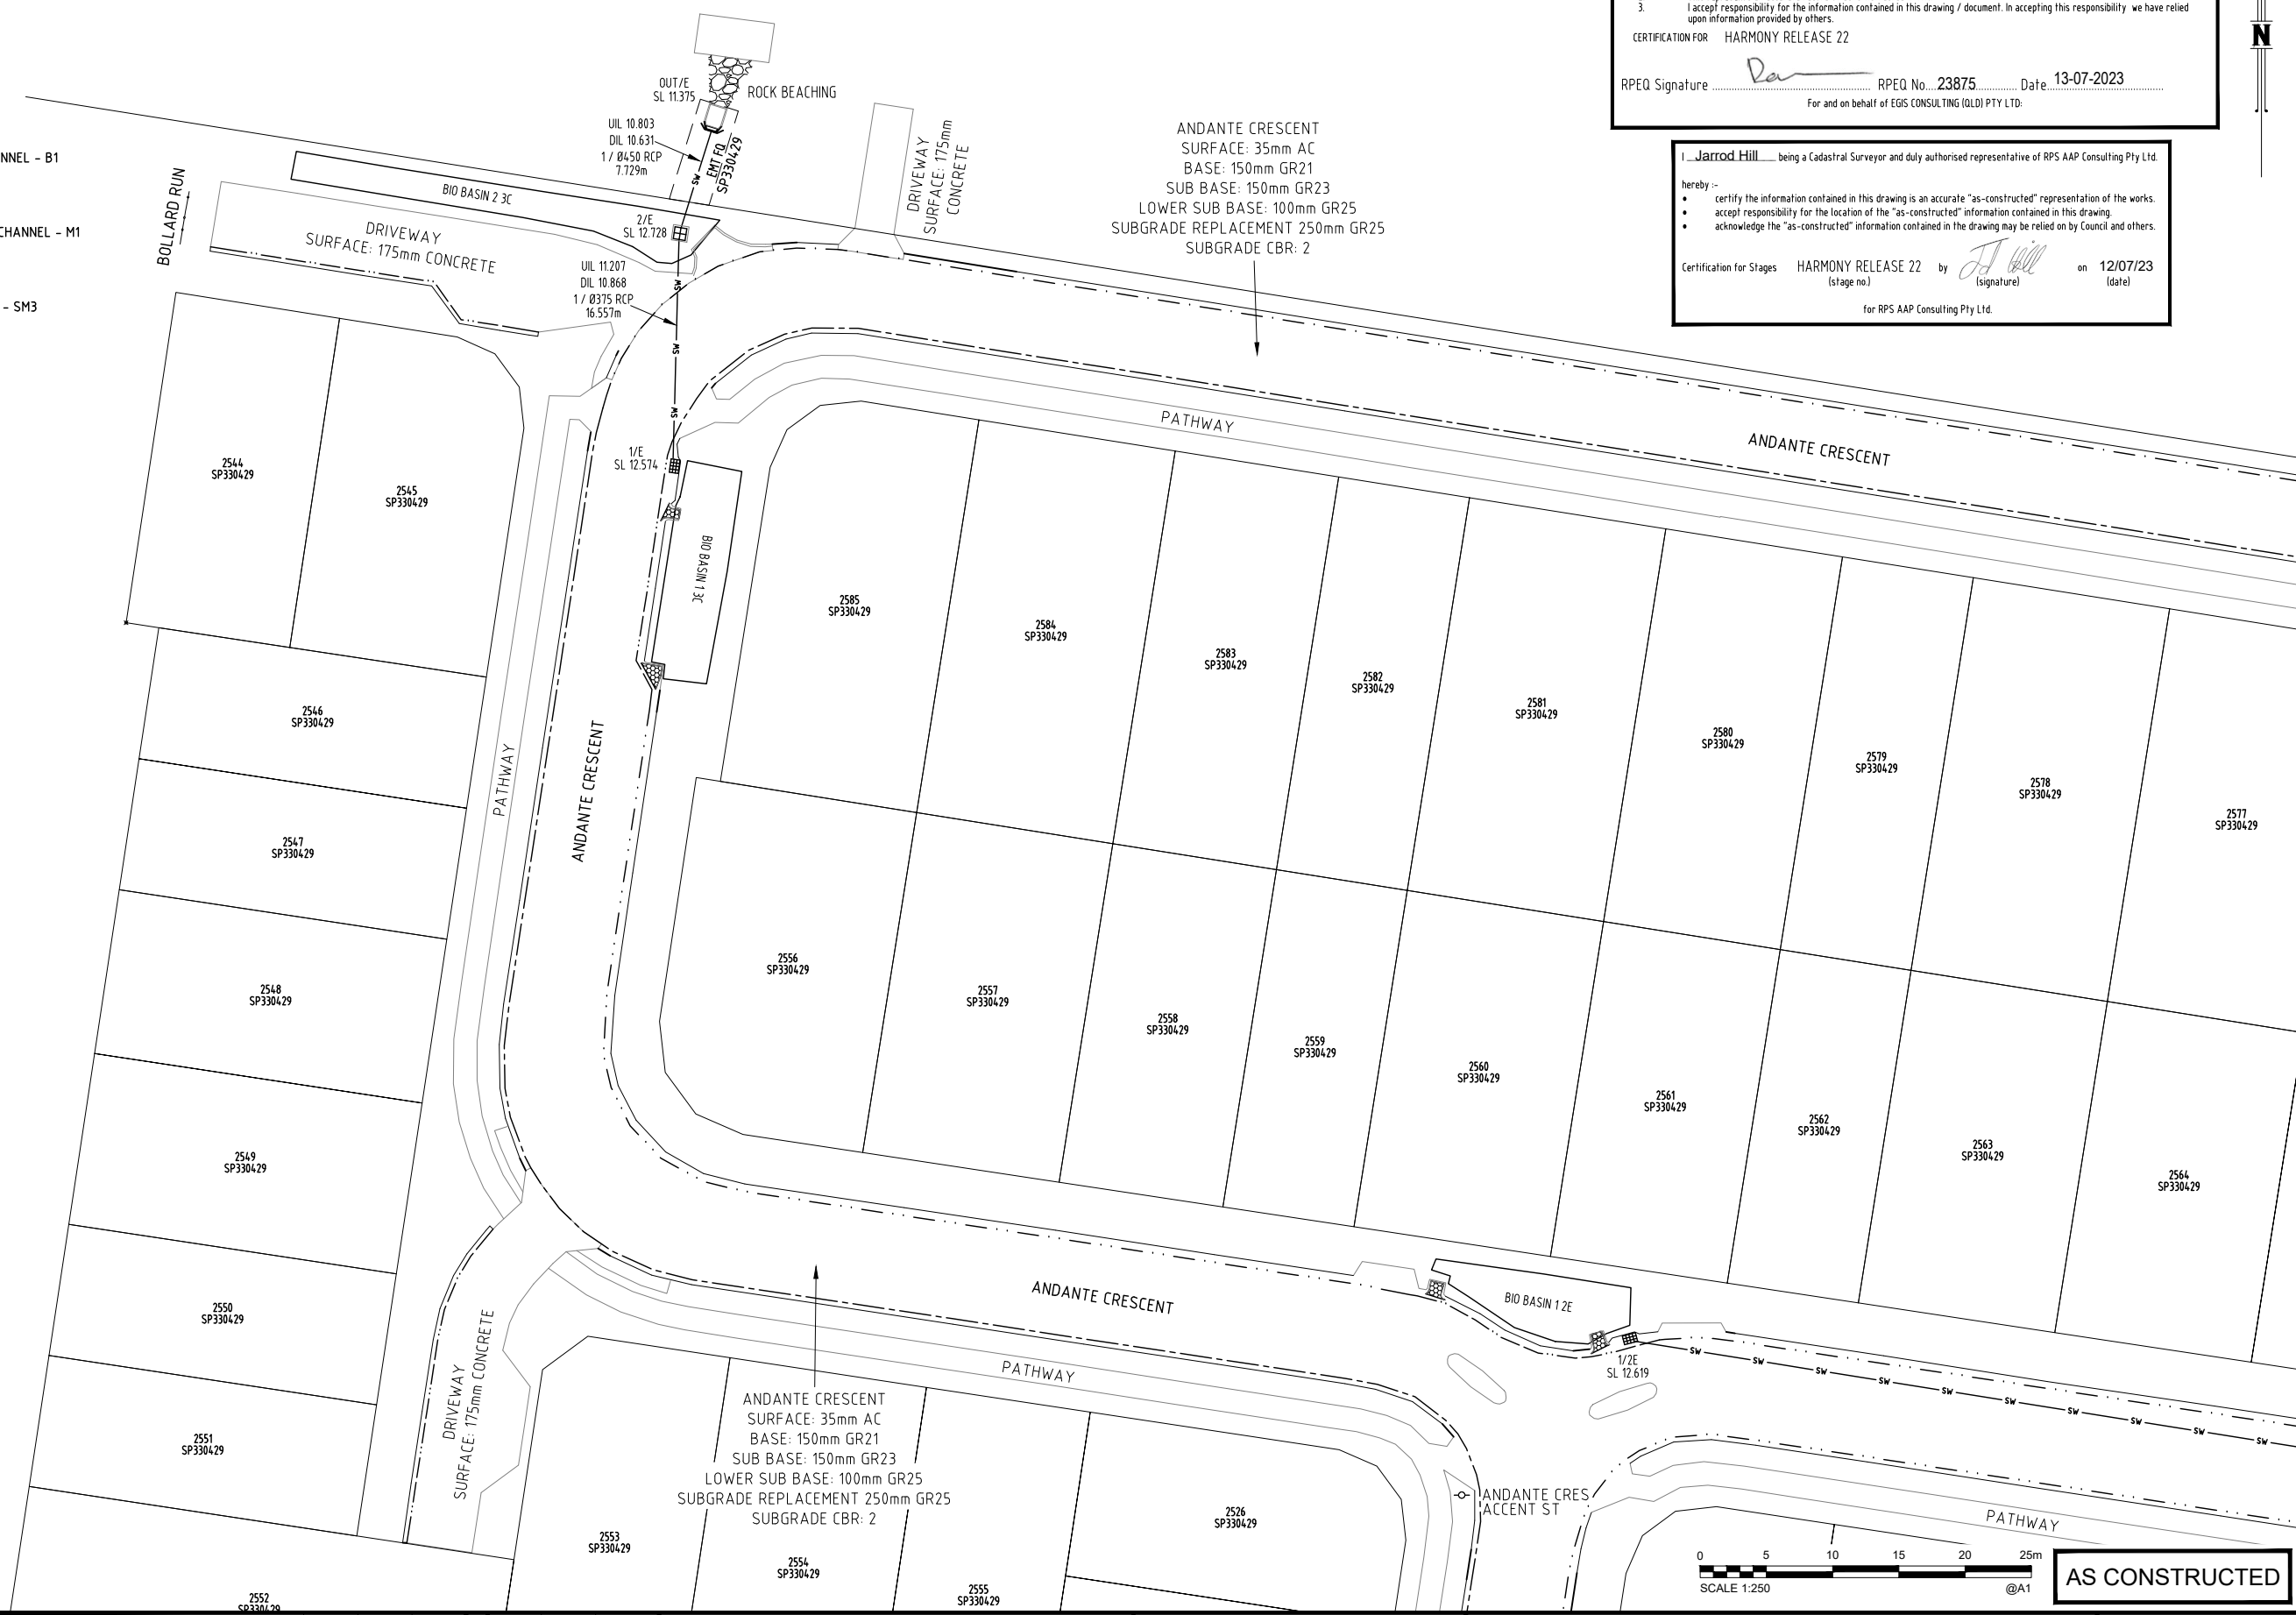

SCALE 1:250 @A1

**AS CONSTRUCTED**

A1									
INDEX	DATE	AS-CONSTRUCTED DETAILS	REVISIONS	DRAWN	CHECKED	PASSED	INITIALS	DATE	SCALE 1:250
	11/07/2023			LG	BS			11/07/2023	SHEET 1 OF 4 SHEETS

DRAWN	LG	11/07/2023
CHECKED	BS	11/07/2023
PASSED		



EGIS CONSULTING Pty Ltd  
Level 4, Unit 401, 8 Market Lane,  
Maroochydore, QLD 4558  
Telephone 07 5314 2520  
Facsimile 07 5314 2522



Sunshine Coast  
COUNCIL

SUNSHINE COAST COUNCIL

ROADS AND DRAINAGE  
HARMONY - RELEASE 22  
COUNCIL REFERENCE: OPW21/0552.01

SCALE	1:250
SHEET	1 OF 4 SHEETS
DRAWING NO.	-

Jarrold Hill being a Cadastral Surveyor and duly authorised representative of RPS AAP Consulting Pty Ltd.

hereby -

- certify the information contained in this drawing is an accurate "as-constructed" representation of the works.
- accept responsibility for the location of the "as-constructed" information contained in this drawing.
- acknowledge the "as-constructed" information contained in the drawing may be relied on by Council and others.

Certification for Stages HARMONY RELEASE 22 by *[Signature]* on 12/07/23  
(stage no.) (signature) (date)

for RPS AAP Consulting Pty Ltd.

Daniel Gibson ENGINEERS CERTIFICATION

I hereby certify that:

- The information contained in this drawing / document is in compliance with approved drawings and design.
- This represents an accurate record of as-constructed works.
- I accept responsibility for the information contained in this drawing / document. In accepting this responsibility we have relied upon information provided by others.


CERTIFICATION FOR HARMONY RELEASE 22

RPEQ Signature *[Signature]* RPEQ No. 23875 Date 13-07-2023


For and on behalf of EGIS CONSULTING (QLD) PTY LTD:

ANDANTE CRESCENT  
SURFACE: 35mm AC  
BASE: 150mm GR21  
SUB BASE: 150mm GR23  
LOWER SUB BASE: 100mm GR25  
SUBGRADE REPLACEMENT 250mm GR25  
SUBGRADE CBR: 2

VANTAGE WAY  
SURFACE: 50mm AC  
BASE: 175mm GR21  
SUB BASE: 175mm GR23  
LOWER SUB BASE: 275mm GR25  
SUBGRADE REPLACEMENT 250mm GR25  
SUBGRADE CBR: 2

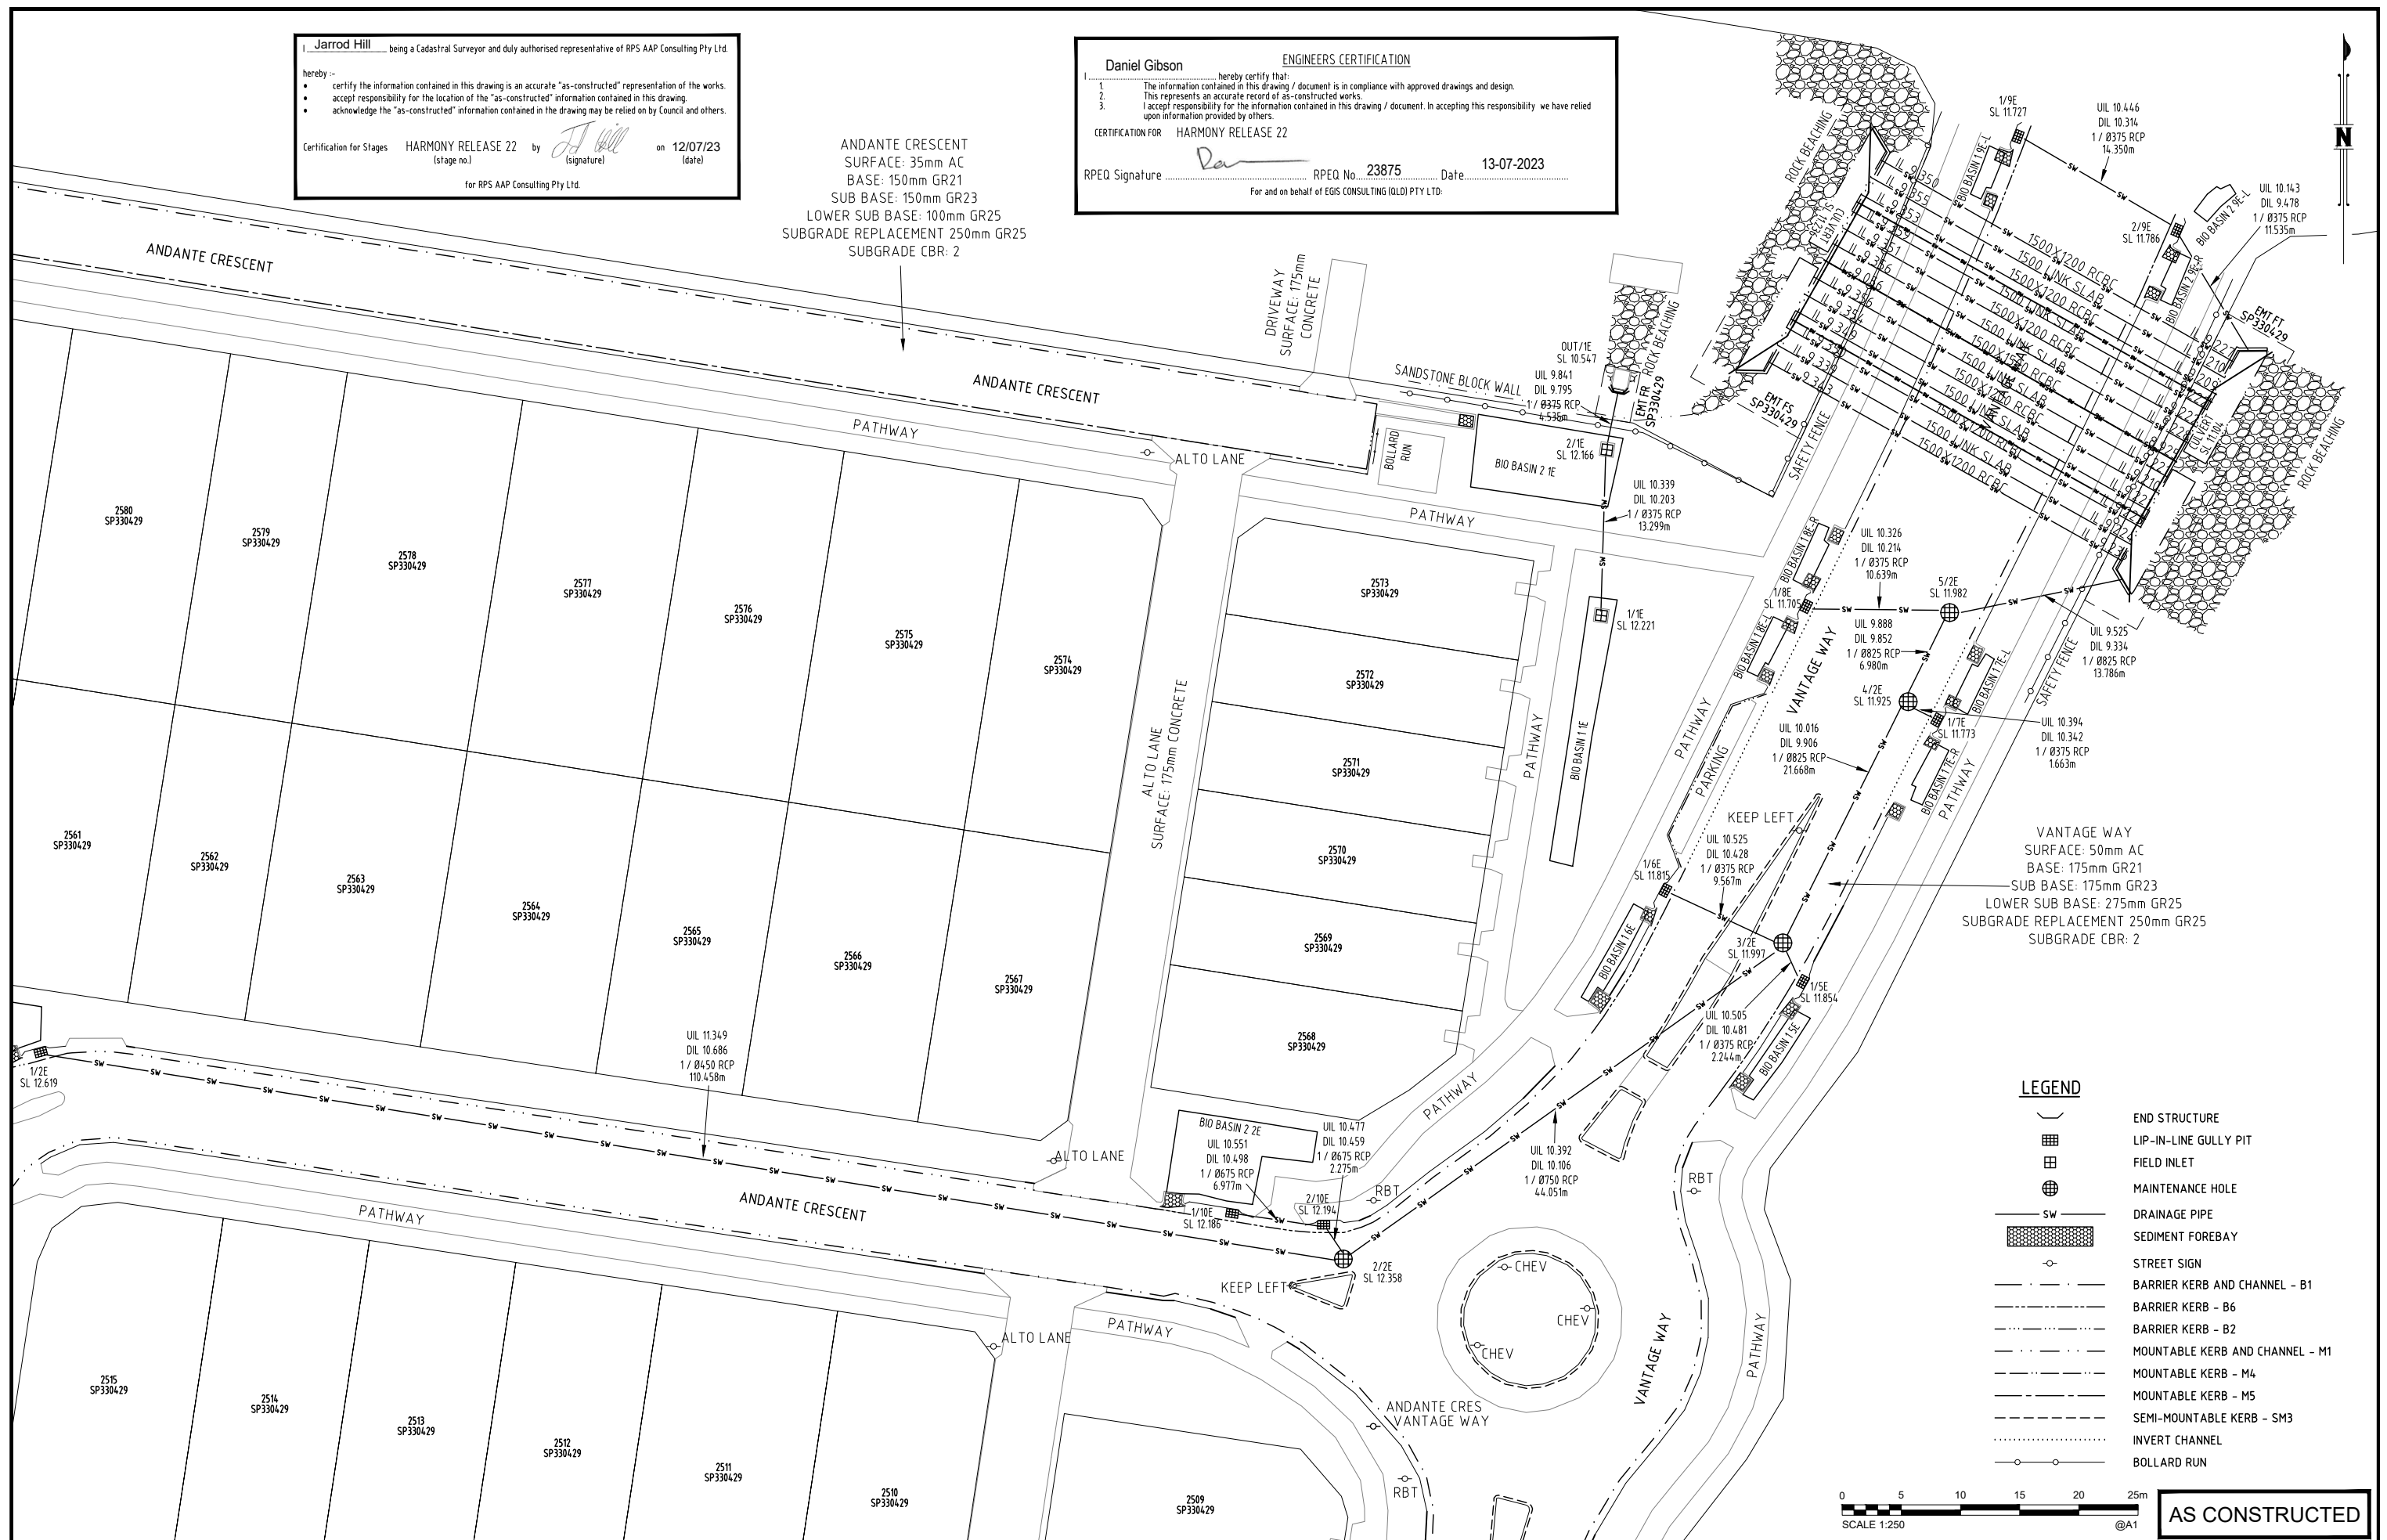

- LEGEND**
- END STRUCTURE
  - LIP-IN-LINE GULLY PIT
  - FIELD INLET
  - MAINTENANCE HOLE
  - DRAINAGE PIPE
  - SEDIMENT FOREBAY
  - STREET SIGN
  - BARRIER KERB AND CHANNEL - B1
  - BARRIER KERB - B6
  - BARRIER KERB - B2
  - MOUNTABLE KERB AND CHANNEL - M1
  - MOUNTABLE KERB - M4
  - MOUNTABLE KERB - M5
  - SEMI-MOUNTABLE KERB - SM3
  - INVERT CHANNEL
  - BOLLARD RUN

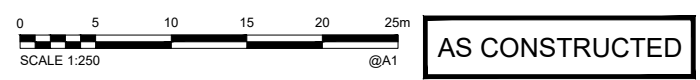

**AS CONSTRUCTED**

A1	0	11/07/2023	AS-CONSTRUCTED DETAILS	LG	BS	
	INDEX	DATE	REVISIONS	DRAWN	CHECKED	PASSED

DRAWN	LG	11/07/2023
CHECKED	BS	11/07/2023
PASSED		
INITIALS	DATE	

**egis** EGIS CONSULTING Pty Ltd  
Level 4, Unit 401, 8 Market Lane,  
Maroochydore, QLD 4558  
Telephone 07 5314 2520  
Facsimile 07 5314 2522



SUNSHINE COAST COUNCIL


ROADS AND DRAINAGE  
HARMONY - RELEASE 22  
COUNCIL REFERENCE: OPW21/0552.01

SCALE	1:250
SHEET 2	OF 4 SHEETS
DRAWING NO.	

**Daniel Gibson** ENGINEERS CERTIFICATION  
 I hereby certify that:  
 1. The information contained in this drawing / document is in compliance with approved drawings and design.  
 2. This represents an accurate record of as-constructed works.  
 3. I accept responsibility for the information contained in this drawing / document. In accepting this responsibility we have relied upon information provided by others.  
 CERTIFICATION FOR HARMONY RELEASE 22  
 RPEQ Signature: [Signature] RPEQ No. 23875 Date 13-07-2023  
 For and on behalf of EGIS CONSULTING (QLD) PTY LTD.

**Jarrold Hill** being a Cadastral Surveyor and duly authorised representative of RPS AAP Consulting Pty Ltd.  
 hereby:-  
 • certify the information contained in this drawing is an accurate "as-constructed" representation of the works.  
 • accept responsibility for the location of the "as-constructed" information contained in this drawing.  
 • acknowledge the "as-constructed" information contained in the drawing may be relied on by Council and others.  
 Certification for Stages HARMONY RELEASE 22 by [Signature] on 12/07/23 (stage no.) (signature) (date)  
 for RPS AAP Consulting Pty Ltd.

- LEGEND**
- END STRUCTURE
  - LIP-IN-LINE GULLY PIT
  - FIELD INLET
  - MAINTENANCE HOLE
  - DRAINAGE PIPE
  - SEDIMENT FOREBAY
  - STREET SIGN
  - BARRIER KERB AND CHANNEL - B1
  - BARRIER KERB - B6
  - BARRIER KERB - B2
  - MOUNTABLE KERB AND CHANNEL - M1
  - MOUNTABLE KERB - M4
  - MOUNTABLE KERB - M5
  - SEMI-MOUNTABLE KERB - SM3
  - INVERT CHANNEL
  - BOLLARD RUN

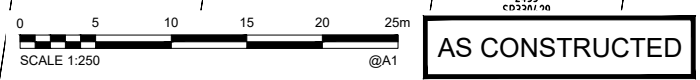

**AS CONSTRUCTED**

<b>A1</b>	0	11/07/2023	AS-CONSTRUCTED DETAILS	LG	BS
	INDEX	DATE	REVISIONS	DRAWN	CHECKED

DRAWN	LG	11/07/2023
CHECKED	BS	11/07/2023
PASSED		
INITIALS	DATE	


EGIS CONSULTING Pty Ltd  
 Level 4, Unit 401, 8 Market Lane,  
 Maroochydore, QLD 4558  
 Telephone 07 5314 2520  
 Facsimile 07 5314 2522

Sunshine Coast COUNCIL

SUNSHINE COAST COUNCIL  
 ROADS AND DRAINAGE  
 HARMONY - RELEASE 22  
 COUNCIL REFERENCE: OPW21/0552.01

SCALE	1:250
SHEET	3 OF 4 SHEETS
DRAWING NO.	



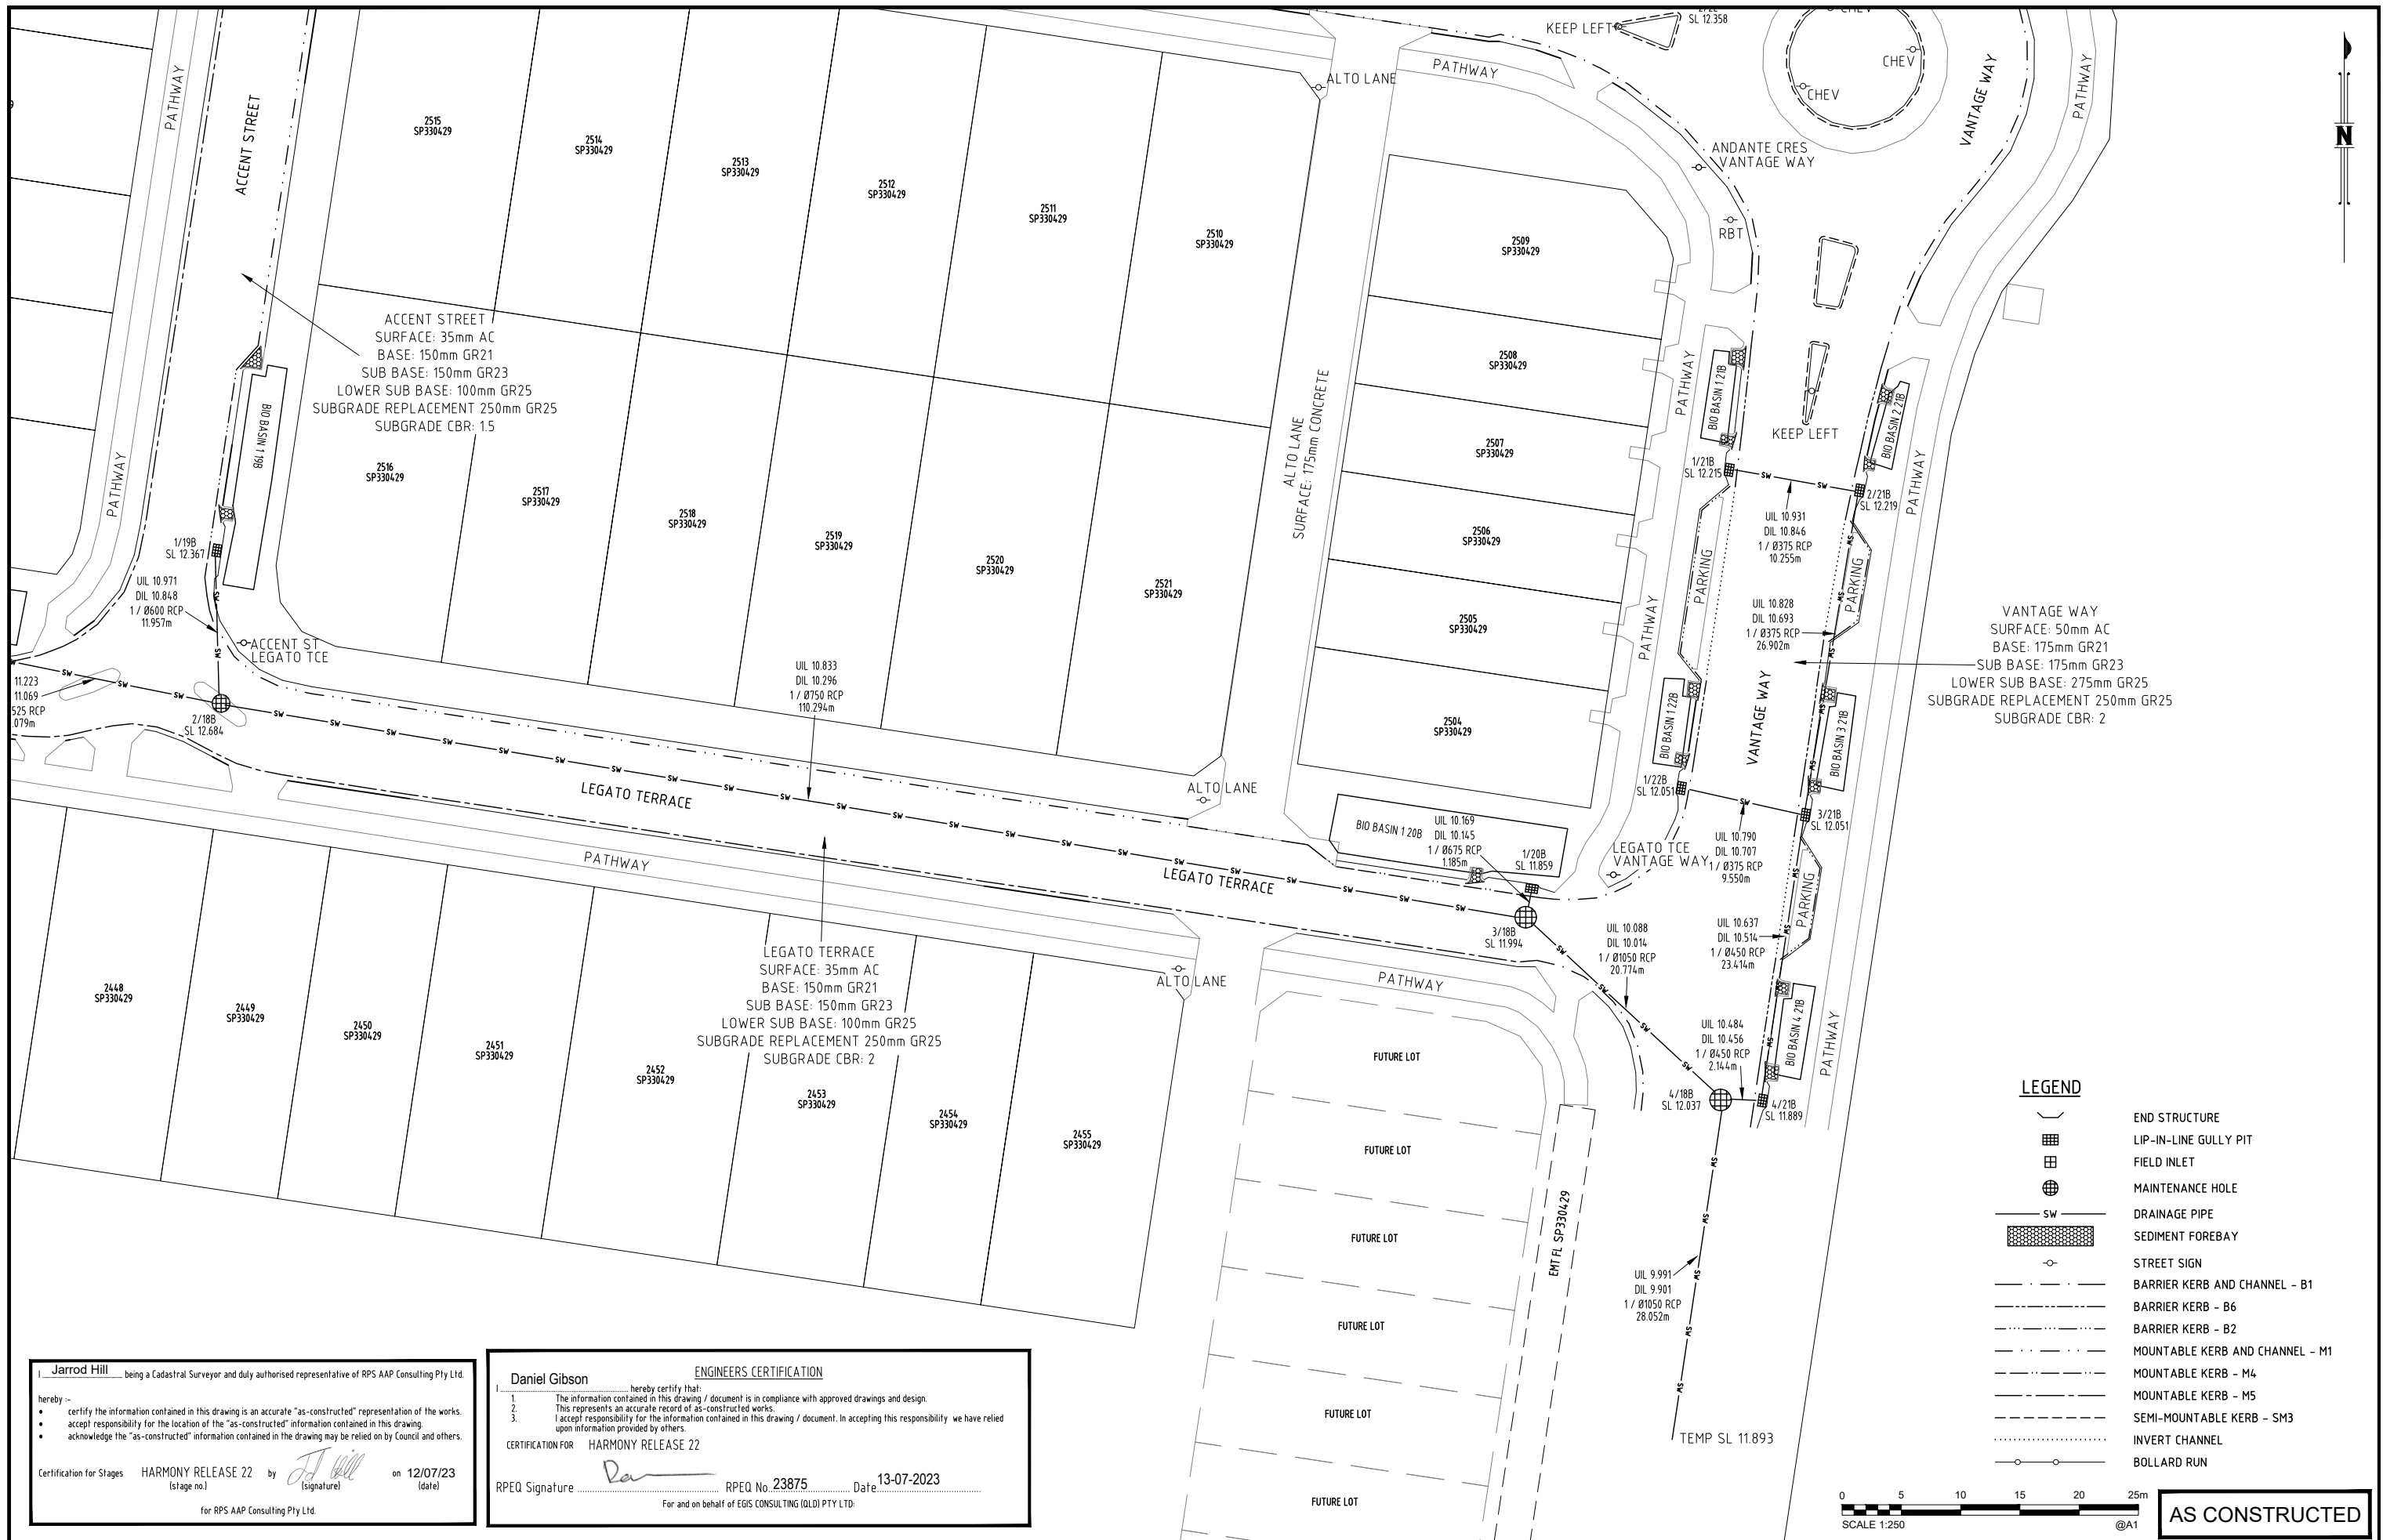

Jarrood Hill being a Cadastral Surveyor and duly authorised representative of RPS AAP Consulting Pty Ltd.

hereby:-

- certify the information contained in this drawing is an accurate "as-constructed" representation of the works.
- accept responsibility for the location of the "as-constructed" information contained in this drawing.
- acknowledge the "as-constructed" information contained in the drawing may be relied on by Council and others.

Certification for Stages HARMONY RELEASE 22 by *Jarrood Hill* on 12/07/23 (stage no.) (signature) (date)

for RPS AAP Consulting Pty Ltd.

**ENGINEERS CERTIFICATION**

Daniel Gibson hereby certify that:

- The information contained in this drawing / document is in compliance with approved drawings and design.
- This represents an accurate record of as-constructed works.
- I accept responsibility for the information contained in this drawing / document. In accepting this responsibility we have relied upon information provided by others.

CERTIFICATION FOR HARMONY RELEASE 22

RPEQ Signature *Daniel Gibson* RPEQ No. 23875 Date 13-07-2023

For and on behalf of EGIS CONSULTING (QLD) PTY LTD.

A1	0	11/07/2023	AS-CONSTRUCTED DETAILS	LG	BS	
	INDEX	DATE	REVISIONS	DRAWN	CHECKED	PASSED

DRAWN	LG	11/07/2023
CHECKED	BS	11/07/2023
PASSED		
INITIALS	DATE	



SUNSHINE COAST COUNCIL  
 ROADS AND DRAINAGE  
 HARMONY - RELEASE 22  
 COUNCIL REFERENCE: OPW21/0552.01

SCALE	1:250
SHEET	4 OF 4 SHEETS
DRAWING NO.	